

Map No. *Kansas* Sec. *17* Twp. *35* R *7*


Well No. *23 Fall City land Co* Farm
Phillips Pet Company

..... Ft. from N. Line

1120 Ft. from S. Line

760 Ft. from E. Line

..... Ft. from W. Line

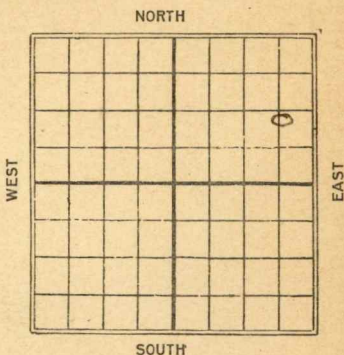

Date
1925

REPORT

3/24 *Slg 900*

5/15 *sand 2701-2712-2727=T.D.*

Map No. KANSAS 3 Sec. 17 Twp. 35 R. 7

Well No. 23 Fall City Land Co
Phillips Pet Company

Contractor

FIRST REPORT

SECTION PLAT

			○

----- Ft. from N. Line

1120' Ft. from S. Line

760' Ft. from E. Line

----- Ft. from W. Line

Location -----

Rig up -----

Drilling and Remarks:

Log at 900'

RECORD

Cased ----- in., ----- ft.

Sand -----

Gas -----

Oil -----

Total Depth -----

PRODUCTION

1st 24 hrs. Nat. -----

1st 24 hrs. after shot -----

Gas ----- Cu. Ft.

Dry Hole -----

Abandoned -----

Date

3/24

1925

M. A. BENEAR

Scout

Map No. *116nd6* Sec. *17* Twp. *35* R. *7*

Well No. *23 Fall City Land Co*
Phillips Pet Co Company

Contractor

COMPLETED

SECTION PLAT

----- Ft. from N. Line

1120 Ft. from S. Line

760 Ft. from E. Line

----- Ft. from W. Line

			o

Location -----

Rig up -----

Drilling and Remarks:

RECORD

Cased _____ in., _____ ft.

Sand *2701-2712*

Gas -----

Oil -----

Total Depth *2727'*

PRODUCTION

1st 24 hrs. Nat. -----

1st 24 hrs. after shot -----

Gas ----- Cu. Ft.

Dry Hole -----

Abandoned -----

Date

MAY 15 1925

192

CHAS. L. SHERWOOD

Scout

60/5 b/s