

Rush

KANSAS

SECTION 18 TOWNSHIP 17 RANGE 16 W

WELL NO. #1 Schrinér

COMPANY Brunson Prld. & Exploration Inc.

NORTH


14

WEST

EAST

SOUTH

0

Rush

KANSAS

SEC. 18	TWP. 17	R. 16W
------------	------------	-----------

WELL NO.

#1 Schriner

FARM

COMPANY

Brunson Prod. &amp; Exploration Inc.

CONTRACTOR

Co. tools

WILDCAT


\_\_\_\_\_ Ft. from N. Line

\_\_\_\_\_ Ft. from S. Line

\_\_\_\_\_ Ft. from E. Line

\_\_\_\_\_ Ft. from W. Line

SW SW SE

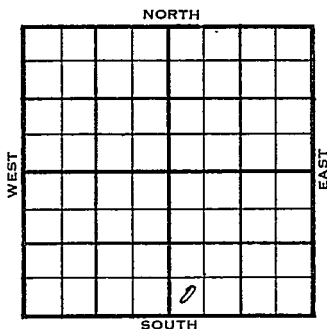

Stanolind FO

1955	ELEVATION 2032'	REPORT
------	--------------------	--------

11-30

MIR

12-21

Comm. 12-4-55

8 5/8" @ 1134/450

DST 3530-52 op 1 hr. rec. 10' mud,  
110/15"

D &amp; A

<del>###</del>	TOPS	DEPTH	LOG
	Anh.		1128
	H.	3254	3255
	Tr.		3271
	L.	3310	3310
	BKG		3532
	Wh		3540

Granite 3587

TD 3591'

ABANDONED

County Rush Elev. \_\_\_\_\_  
 Sec. 18 Twp. 17 Rge. 16W  
 Company Brunson Prod. & Exploration Inc.  
 Farm Name Schriner No. 1

TOPS	DEPTH	LOG	DATUM	Loc. in Sec.
Anh.				SW SW SE
Tr.				
H.				
Tr.				
Dg.				
Bl.				
L.				Geol. _____
K.C.				Contr. _____
B.K.C.				
Ce.				Co. tools
C.				
M.				Pool
M.				Wildcat
K.				
Mz.				
Me.				
V.				
S.				
S.				
A.				
R.				
Pe.				
G.				
T.D.				

NOV 30 '55  
 FIRST REPORT

Date Comm. M I R Stanolind FO

*[Large handwritten scribble/signature across the bottom of the page]*

Co.  
Lse.  
No.  
Sec.  
T.  
R.

County Rush Elev. 2032  
 Sec. 18 Twp. 17 Rge. 16W  
 Company Brunson Prod. & Exploration Inc.  
 Farm Name Schriner No. 1

TOPS	DEPTH	LOG	DATUM	Loc. in Sec.
Anh.		<u>1128</u>		SW SWSE
Tr.				
H.	<u>3254</u>	<u>3253</u>	<u>1223</u>	
Tr.		<u>3271</u>	<u>1239</u>	
Dg.				
Bl.				
L.	<u>3310</u>	<u>3310</u>	<u>1278</u>	Geol.
K.C.				Contr.
B.K.C.		<u>3532</u>	<u>1500</u>	Co. tools
Ce.				Pool
C.				Wildcat
M.				<div style="border: 1px solid black; padding: 5px; text-align: center;">                     ABANDONED                      /                      2                 </div>
M.				
K.				
Mz.				
Me.				
V.				
S.				
S.				
A.				
R.				
Pe.				
G. wh		<u>3540</u>	<u>1528</u>	
Granite	<u>3587</u>		<u>1535</u>	
T.D.	<u>3591</u>			

Date Comm. 12-4-55 DEC 21 1955

8 5/8" @ 1134/450 DST 3 530-52 open 1 hr

rec. 10' mud 110/15"

D & A