

KANSAS


SEC. 24 TWP. Rush 17 R. 16 W

WELL NO. # 1 Schlagel FARM

COMPANY Northern Pump

CONTRACTOR Northern Pump Wildcat

_____ Ft. from N. Line
330 _____ Ft. from S. Line
 _____ Ft. from E. Line
990 _____ Ft. from W. Line

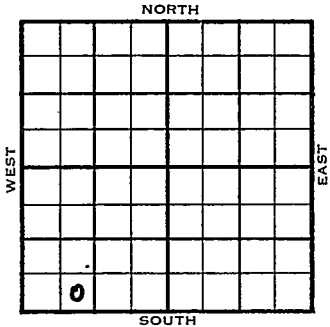

SE SW SW

1953 ELEVATION Elev. 2044' REPORT

10/7 Location
 10/14 8" @ 832 Anhy 1120'
 Drlg. 2100'
 10/21 Heeb 3282' Lans 3368
 DST 3432-40, 1/2 hr, 15' M 1025#
 Drlg. 3566'
 10/28 Spud 10-8-53 D & A TD 3695
 8" @ 832 Anhy 1120 Heeb 3282
 Lans 3368
 DST 3432-40 open 1/2 hr rec 15' mud
~~1025#~~ 1025# Cong 3586' Arb. 3647'
 TD 3695' D & A

ABANDONED

