KANSAS

Form 51—5M—7-40—Palace


Barton

Section 30 Township 16 Range 11-W

Well No. #3 Krier "A"

Company B.B. & M. et al

Prusa Pool

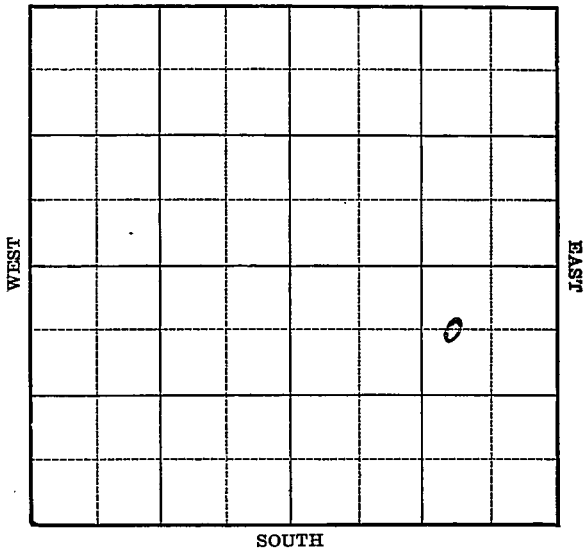

FORM 252-A 5M 1-41 PETROL **KANSAS** Barton

Sec. 30 Twp. 16 R. 11-W

Well No. #3 Krier "A" Farm

B B & M et al Company


(Prusa)

660 Ft. from N. Line

Ft. from S. Line

990 Ft. from E. Line

Ft. from W. Line

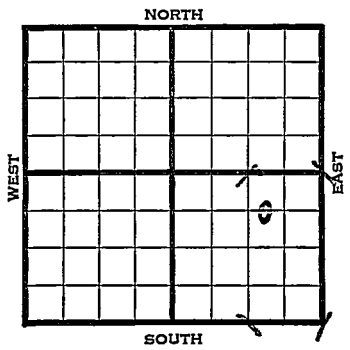

1941	REPORT
5/14	Cable.
5/22	12" - 444' Anhy 472'
	10" - 745' Drlg. 1060'
5/28	2151' run 8".
6/5	8" - 2305' Fsg. 2465'
6/12	Drlg. 2540'
6/19	Lans. 3056' 7" - 3056' C.O.
6/26	T.D. 3075' 3000' oil 12 hours.
	3000 acid. Flow 165 oil in 2
	hours.
7/3	" "
7/9	Lans. 3056'
	7" - 3056'
	T.D. 3075'
	3000 acid.
	Potential 1439 bbls., pump.
	43. Gravity
	COMPLETED

Form 26—200 Bks.—1-40—Palace Barton **KANSAS**

Map No. 56 Sec. 30 Twp. 16 R. 11W

Well No. 3 Krier "A"

B B & M. etal Company

FIRST REPORT Contractor

C W L NE SE

660 Ft. from N. Line


_____ Ft. from S. Line

990 Ft. from E. Line

_____ Ft. from W. Line

PRUSA POOL

SECTION PLAT

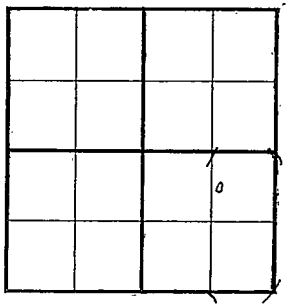

Location _____

Rig up _____

Drilling and Remarks:

Cable

RECORD

Cased _____ in., _____ ft.

Sand _____

Gas _____

Oil _____

Total Depth _____

PRODUCTION

1st 24 hrs. Nat. _____

1st 24 hrs. after shot _____

Gas _____ Cu. Ft.

Dry Hole _____

Abandoned _____

Date

MAY 14 1941 19____ S. J. LEWIS Scout

Form 26 200 Bks. 5-41 McW. Barton KANSAS

Map No. _____ Sec. 30 Twp. 16 R. 11W

Well No. 3 Krier "A"

B. B. & M etal Company

COMPLETED Contractor

C W L NE SE

660 Ft. from N. Line


_____ Ft. from S. Line

990 Ft. from E. Line

_____ Ft. from W. Line

PRUSA POOL

SECTION PLAT

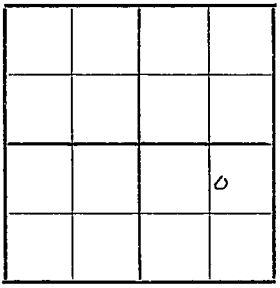

Location _____

Rig up _____

Drilling and Remarks:

Lans 3056
7" @ 3056
3000 acid
Pump 1439 BO
430 Gr

RECORD

Cased _____ in., _____ ft.

Sand _____

Gas _____

Oil _____

Total Depth 3075

PRODUCTION

1st 24 hrs. Nat. _____

1st 24 hrs. after shot _____

Gas _____ Cu. Ft.

Dry Hole _____

Abandoned _____

Date

JUL 9 1941 19 S. J. LEWIS Scout