

KANSAS


Form 51-5M-7-39-Palace

Rush

Section 34 Township 17 Range 16-W

Well No. #1 Schlegel

Company Power Oil & Crawford

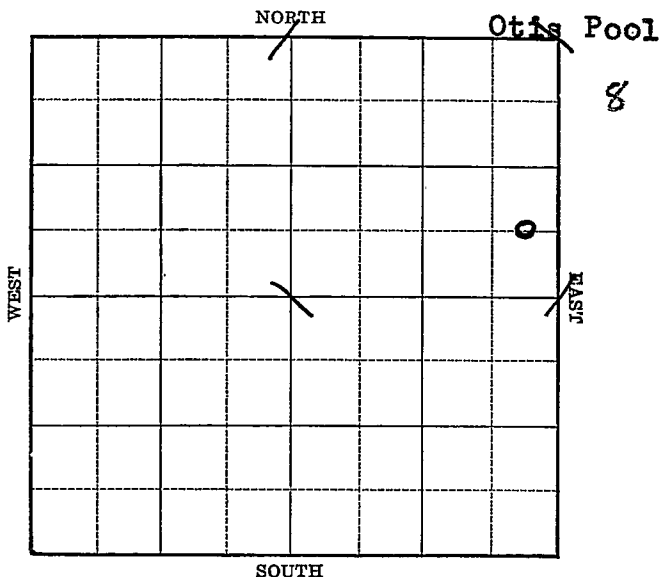

KANSAS


Rush

Sec. 34 Twp. 17 R. 16-WWell No. #1 Schlegel FarmPower Oil & Crawford Company

(Otis)

 Ft. from N. Line660 Ft. from S. Line330 Ft. from E. Line Ft. from W. Line

Elev. 2005

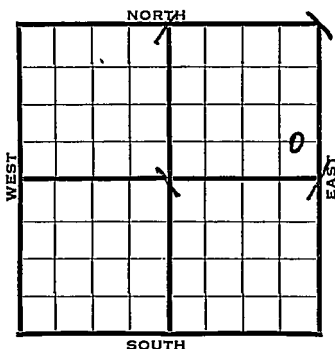

1940

REPORT

6/12 Derrick.

6/20 8" - 1061' Anhy 1066'

Drlg. 1921'

6/27 Drlg. 3400'

7/3 Lans. 3335-3505'

Drlg. 3624'

7/10 Granite wash 3502'

Granite 3656'

T.D. 3661'

ABANDONED


Rush

Map No. 74 Sec. 34 Twp. 17 R. 16WWell No. 1 SchlegelPower Oil & Crawford Company

Contractor

FIRST REPORT
C E L S E N E

SECTION PLAT

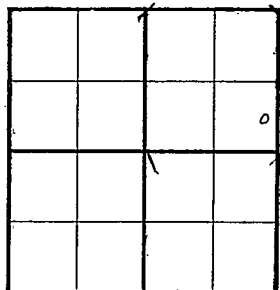 Ft. from N. Line660 Ft. from S. Line330 Ft. from E. Line Ft. from W. Line

OTIS POOL

Location Rig up Drilling and Remarks: Derrick

RECORD

Cased in., ft.Sand Gas Oil Total Depth

PRODUCTION

1st 24 hrs. Nat. 1st 24 hrs. after shot Gas Cu. Ft.Dry Hole Abandoned

Date

JUN 12 1940 19S. J. LEWIS Scout

