


Section 30 Township 16 Range 11 WWell No. # 8 Krier "A"Company Pam-Kar

NORTH

WEST

EAST

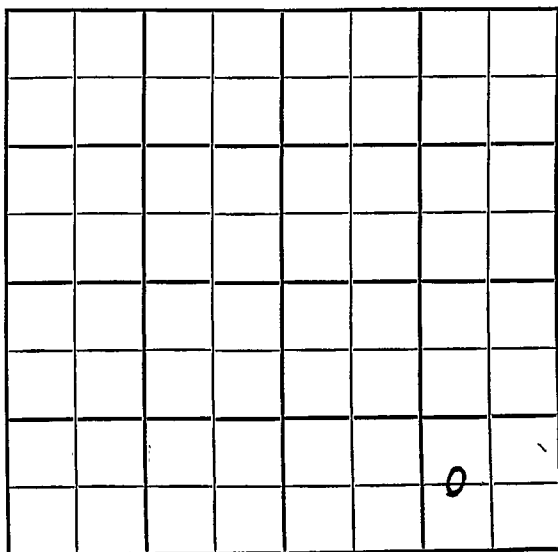

SOUTH

Barton KANSAS

SEC.	TWP.	R.
30	16	11W

WELL NO.

8 Krier "A"

FARM

COMPANY

Pam-Kar

CONTRACTOR

Co. Tools

Kraft-Prusa Pool

Ft. from N. Line


660

Ft. from S. Line

990

Ft. from E. Line

Ft. from W. Line

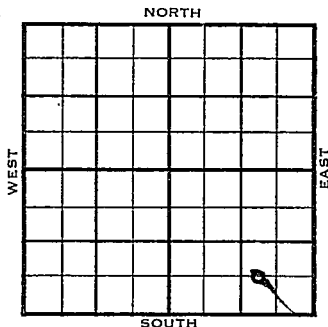

C W/2 SE SE

ELEVATION	REPORT
1954	1921'

8/18

MIR

10/6

Spud 8-17-54

Oil Well

TD 3264'

8" @ 381'

Anhy 760', Heeb 2924', Br. Lime 3021'

Lans 3041', Tor. 2942', Doug 2968'

TD 3264'

5" @ 3264'

24/ 2971-77 frac. 20/ 3118-25

sd-oil-frac. 2000 A 1 bwph

PB 3096'

18/ 3040-46 12/ 3051-55 2000 A

Comp 21 bopd.

COMPLETED

County **Barton** State **Kansas**

Sec. **30** (Blk. **16** (Sur. **11W** Map No.

Operator **Pam-Kar**

Well No. 8 Farm Krier "A"

Elev.	Location	C	W $\frac{1}{2}$	SE	SE
-------	----------	---	-----------------	----	----

FIRST REPORT

660 Ft. From S Line SE

990 Ft. From E Line Quarter

1st. Report AUG 18 1954

Completion

Remarks.

Co. tools

Spudding Date


Kraft-Pruse Pool

Drlg. Data

M I R

FABEN GILSTRAP

County Barton State Kansas
 Sec. 30 (Blk.) 16 (Sur.) 11W Map No.
 Operator Pam-Kar
 Well No. 8 Farm Krier "A"
 Elev. 1921 Location C W $\frac{1}{2}$ SE SE

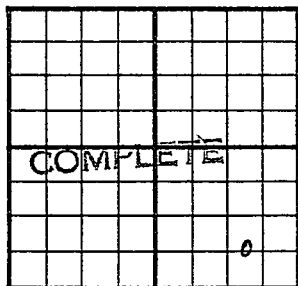

660 Ft. From S Line SE
990 Ft. From E Line Quarter
 Ist. Report
 Completion OCT 6 1954
 Remarks Kraft-Prusa Pool
Co. tools
 Spudding Date 8-17-54

Drlg. Data Oil well TD 3264
8" @ 381 Anhy 760 Heeb. 2924
Br. lime 3021 Lans. 3044 Tor. 2942
Doug. 2968 TD 3264 5" @ 3264
24/ 2971-77 frac 20/ 3118-25
sd-oil-frac 2000 A 1 bwph PB 3096
18/ 3040-46 12/ 3051-55 2000 A
Comp. 21 bopd

FABEN GILSTRAP