

Butler

KANSAS


SECTION 3 TOWNSHIP 25 RANGE 5EWELL NO. #1² Nuttle "C" (KGS DRL)COMPANY Frank H. Dieter

NORTH

~~SW NE SE~~
~~SE NW SE~~

WEST

EAST

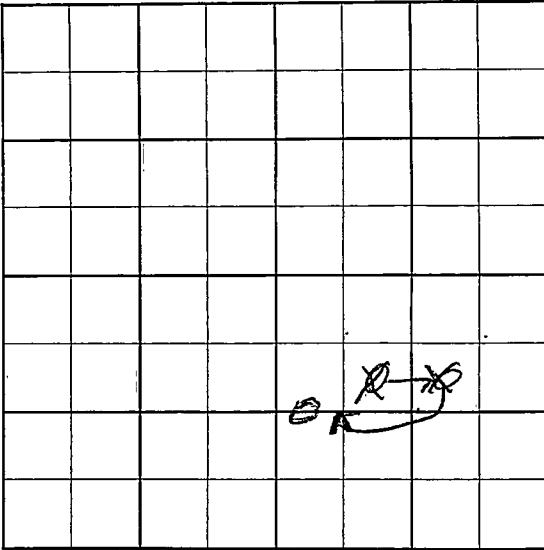

SOUTH

County Butler Elev. _____
 Sec. 3 Twp. 25 Rge. 5E
 Company Frank H. Dieter
 Farm Name Nuttle "D" No. 12
 (K65 DR4)

TOPS	DEPTH	LOG	DATUM	Loc. in Sec.
Anh.				SE NW SE
Tr.				
Dg.				
Bl.				
L.				Geol.
K.C.				Contr.
B.K.C.				Berentz Dr1
Ce.				Pool
C.				Eldorado
M.				
M.				
K.				
Mz.				
Ma.				
V.				
S.				
S.				
A.				
R.				
Pe.				
G.				
T.D.				

JUL	3	57
FIRST REPORT		

Date Comm. RURT

1.01

Co.
No.
Sec.
T.
R.

CORRECTION

County Butler Elev. 1361 RB
 Sec. 13 Twp. 25 Rge. 5E
 Company Frank H. Dieter
 Farm Name Nuttle "D" No. 72
 (KGS 044)

TOPS	DEPTH	LOG	DATUM	Loc in Sec.
Anh.				SE NW SE
Tr.				SW NE
H.				
Tr.				
Dg.				
BL.				
L.				
K.C.	1999			Geol.
B.K.C.	2166			Contr.
Ce. <u>Lenap</u>	2237			Berentz Drlg.
C. <u>Peru</u>	2252-00			
M.				Pool
M.				El Dorado
K.				
Mz.				
Mo.				
V.				
S.				
S.				
A.				
R.				
Pe.				
G.				
TD	2266			

COMPLETE

SEP 11 '57

Date Comm.

RURT JUL 10 '57 7-2-57 85/8 62

Crd 2254-66 rev 12' 4 1/2

2253 WOCT JUL 24 '57 JUL 31 '57

AUG 13 '57 AUG 21 '57 AUG 28 '57 SEP 4 '57

SEP 11 '57 TD 2267 + 2 c on

DOP 25 BOPd + wtr

CORRECTION

on comp. ticket 7-7-57

S-513-B

County Butler Elev. 1356 DF
 Sec. 3 Twp. 25 Rge. 5E
 Company F. H. Dieter
 Farm Name Nuttle "C" No. 2

TOPS	DEPTH	LOG	DATUM
Anh.			
Tp.			
H.			
Tr.			
Dg.			
B.L.			
L.			
K.C.			
B.K.C.			
Ce.			
C.			
M.			
M.			
K.			
Mz.			
Mq.			
V.			
S.			
S.			
A.			
R.			
Pf.			
G.			
T.D.			

Loc. in Sec. W $\frac{1}{2}$ W $\frac{1}{2}$ SE
1320' SL
2500' EL

Geol. _____
 Contr. _____
 Pool. El Dorado

MAY	4	'58

Date Comm. _____
Comp. 7-7-57 as #1 Nuttle "D" in SW NE SE

(C)