
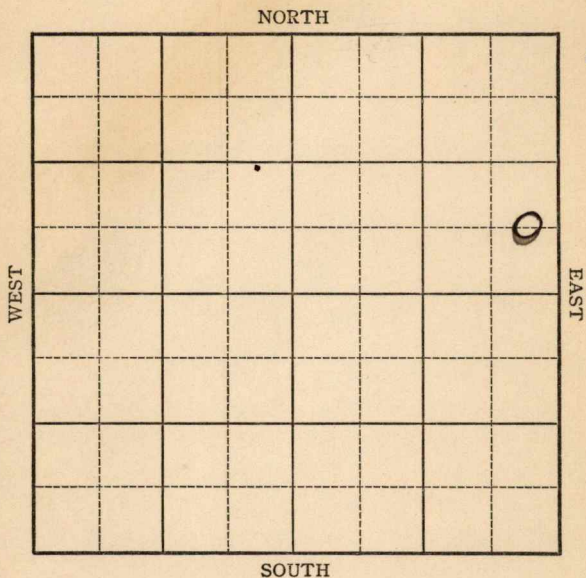


Chaut.

Section 10 Township 35 Range 12-E
Well No. 1 - Gwinn
Company C. E. Roth

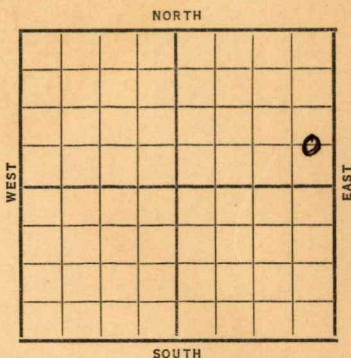

Sec. 10 Twp. 35 R. 12-EWell No. #1 Gwinn FarmC. E. Roth Company Ft. from N. Line660 Ft. from S. Line330 Ft. from E. Line Ft. from W. Line

Date	REPORT
1937	
9/1	Mat.
9/10	"
9/17	"
9/24	Drlg. 275'.
10/2	" "
10/8	Drlg. 1350'.
10/15	Miss. 1725'. 6" @ 1730'.
	Fsg. 1934'. S.G.
10/22	Base Miss. 1994'.
	Drlg. 2025'.
10/29	" "
11/5	" "
11/10	6" @ 1730'.
	Miss. 1725'.
	Sil. 2035'.
	T.D. 2038'. H.F.W.
	COMPLETED

Chaut. **KANSAS**Map No. 4 Sec. 10 Twp. 35 R. 12EWell No. 1 - SwinnC. E. Roth Company

Contractor

FIRST REPORT

SECTION PLAT

			0

_____ Ft. from N. Line

660 Ft. from S. Line330 Ft. from E. Line

_____ Ft. from W. Line

Location _____

Rig up _____

Drilling and Remarks:

Mat

RECORD

Cased _____ in., _____ ft.

Sand _____

Gas _____

Oil _____

Total Depth _____

PRODUCTION

1st 24 hrs. Nat. _____

1st 24 hrs. after shot _____

Gas _____ Cu. Ft.

Dry Hole _____

Abandoned _____

Date

SEP 1 1937 19

H. D. Hatfield Scout

Chautauqua

KANSAS

Map No. 4 Sec. 10 Twp. 35 R. 12EWell No. 1 GwinnC. E. Roth

Company

Contractor

ABANDONED

SECTION PLAT

			0

 Ft. from N. Line660 Ft. from S. Line330 Ft. from E. Line Ft. from W. LineLocation Rig up

Drilling and Remarks:

HFW

DVA

RECORD

Cased 6 in., 1730 ft.Sand MISS 1725Gas 511 2035Oil Total Depth 2038

PRODUCTION

1st 24 hrs. Nat. 1st 24 hrs. after shot Gas Cu. Ft.Dry Hole Abandoned

Date

NOV 10 1937 19

H. D. Hatfield Scout