

KANSAS


Butler County

FORM 51 5M PETROL

Section 3 Township 25 Range 5E

Well No. 24 Robinson

Company Deep Rock

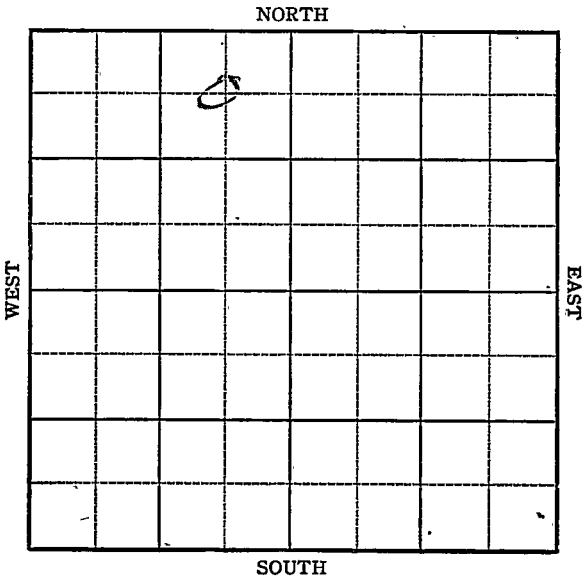

KANSAS

Butler

Sec. 3 Twp. 25 R. 5E

Well No. 24 Robison Farm

Deep Rock Company

Miscellaneous


 Ft. from N. Line

1800 Ft. from S. Line

600 Ft. from E. Line

 Ft. from W. Line

C NE NW *to line . 1376*

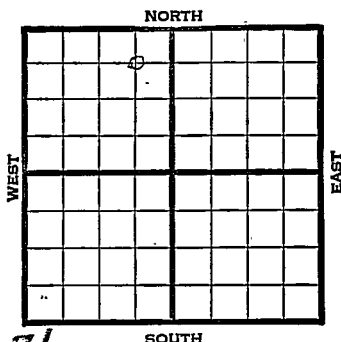

1945

REPORT

5/29	Location
6/8	Machiner
6/14	12" @ 132
	Drlg. 1745
6/21	Drlg. 2200
	8" @ 2185
7/3	Viola 2445
	7"2 @ 2445
	TD 2447'
	1000 acid.
	Pump 60 Pot.
	Grav. 39.0

COMPLETED


Kansas Pool Name MiscellaneousMap No. 14 Sec. 3 Twp. 25 R. 5EWell No. 24 RobinsonDeep Rock Company

FIRST REPORT

Contractor

C NE NW

SECTION PLAT

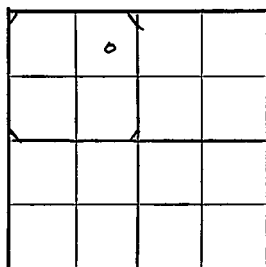2600 Ft. from N. Line1800 Ft. from S. Line600 Ft. from E. Line Ft. from W. Line

Butler

Location XRig up

Drilling and Remarks:

RECORD

Cased in., ft.Sand Gas Oil Total Depth

PRODUCTION

1st 24 hrs. Nat. 1st 24 hrs. after shot Gas Cu. Ft.Dry Hole Abandoned

Date

MAY 29 1945 19 S. J. LEWIS Scout

KANSAS

Well Name MiscellaneousMap No. 14 Sec. 3 Twp. 25 R. 5EWell No. 24 RobinsonDeep Rock Company**COMPLETED**

Contractor

C NE NW

SECTION PLAT

	o		

 Ft. from N. Line1800 Ft. from S. Line600 Ft. from E. Line Ft. from W. LineButler CountyLocation Rig up

Drilling and Remarks:

Wt 24457" @ 24451000 acidPump 60 Pst280 cu

RECORD

Cased in., ft.Sand Gas Oil Total Depth 2447

PRODUCTION

1st 24 hrs. Nat. 1st 24 hrs. after shot Gas Cu. Ft.Dry Hole Abandoned

Date

JUL 3 1945S. J. LEWIS Scout