


Section 3 , Township 25 Range 5E

Well No. 25 Robinson

Company Deep Rock

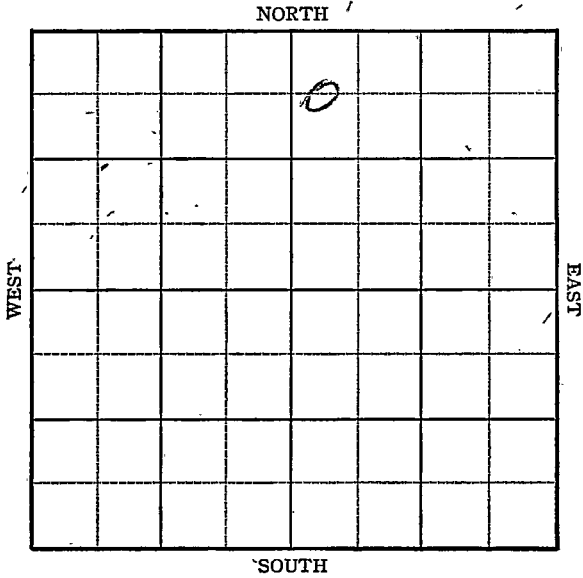

KANSAS

Butler

Sec. 3 Twp. 25 R. 5-E

Well No. #25 Robinson Farm

Deep Rock Company


Misc.

643 Ft. from N. Line

_____ Ft. from S. Line

_____ Ft. from E. Line

123 Ft. from W. Line

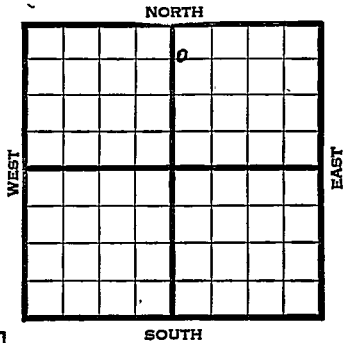

C W L NW NE Elev. 1361

1945

REPORT

- 7/3 Location
- 7/11 12" @ 98
Drlg. 900'
- 7/19 Drlg. 1760
10" @ 1450
- 7/26 8" @ 2133
KC. 1970
Drlg. 2345
- 8/8 Viola 2455
7" @ 2455'
T.D. 2458'
Pump 45 pot.
Gravity 38

COMPLETED

KANSAS
Kansas Pool Name MiscellaneousMap No. 14 Sec. 3 Twp. 25 R. 5EWell No. 25 RobinsonDeep Rock Company

FIRST REPORT

Contractor

C W L NW NE

SECTION PLAT

		0	

643 Ft. from N. Line

_____ Ft. from S. Line

_____ Ft. from E. Line

123 Ft. from W. Line

Butler County

Location X

Rig up _____

Drilling and Remarks:

RECORD

Cased _____ in., _____ ft.

Sand _____

Gas _____

Oil _____

Total Depth _____

PRODUCTION

1st 24 hrs. Nat. _____

1st 24 hrs. after shot _____

Gas _____ Cu. Ft.

Dry Hole _____

Abandoned _____

Date

JUL 3 1945 19S. J. LEWIS Scout

KANSAS
1/2/Pool Name MiscellaneousMap No. _____ Sec. 3 Twp. 25 R. 5EWell No. 25 Robinson

Deep Rock _____ Company

COMPLETED _____ Contractor

C W L NW NE

SECTION PLAT

		o	

643 Ft. from N. Line

_____ Ft. from S. Line

_____ Ft. from E. Line

123 Ft. from W. Line

Butler County

Location _____

Rig up _____

Drilling and Remarks:

*Viola 2455**7" 02455**Pump 45 ft**38-2-4*

RECORD

Cased _____ in., _____ ft.

Sand _____

Gas _____

Oil _____

Total Depth 2455

PRODUCTION

1st 24 hrs. Nat. _____

1st 24 hrs. after shot _____

Gas _____ Cu. Ft.

Dry Hole _____

Abandoned _____

Date

AUG 8 1945 19S. J. LEWIS Scout