


Chautauqua KANSAS

SECTION 4 TOWNSHIP 35 S RANGE 13 E

WELL NO. # 1 Boyd

COMPANY L. B. Smith

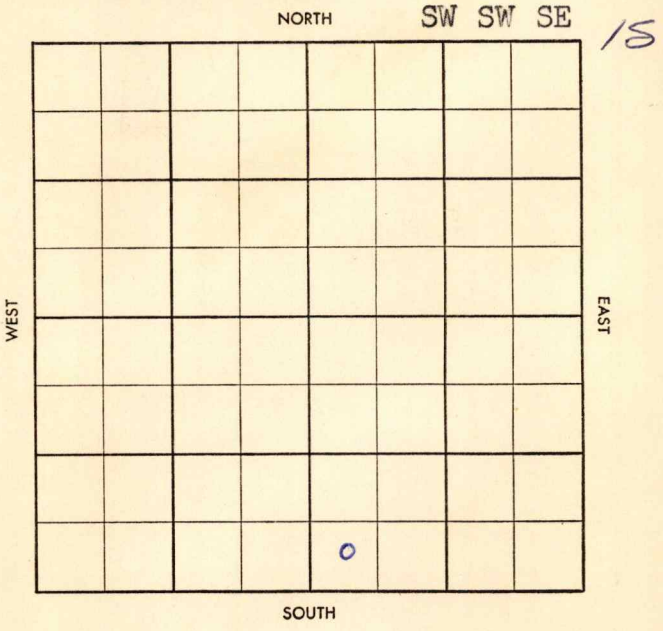

Twp. --- Pool ---  
Co. --- Facet ---

S-513-B

County Chautauqua Elev. 848 DF Est  
 Sec. 4 Twp. 35S Rge. 13E  
 Company L. E. Smith  
 Farm Name Boyd No. 1

TOPS	DEPTH	LOG	DATUM
Anh.	<u>lay</u>	<u>A17</u>	
Tp.			
H.			
Tr. <u>Burg</u>	<u>1660</u>		
Dg.			
B.L.			
L.			
K.C.		<u>836</u>	
B.K.C.	<u>Maem</u>	<u>935</u>	
Ce.		<u>1234</u>	
C.			
M.	<u>1668</u>	<u>1676</u>	
M.		<u>1693</u>	
K.	<u>Chat</u>	<u>1948</u>	
Mz.			
Mq.			
V.			
S.			
S.			
A.		<u>2007</u>	
R.			
Pf.			
G.			
T.D.			

Loc. in Sec. SW SW SE  
 Geol. \_\_\_\_\_  
 Contr. \_\_\_\_\_  
 Pool Wildcat

**ABANDONED**  
 SEP 24 '58  
 0

Date Comm. Spud 9/10/58 Phillips-(Support)

SEP 17 '58 8" 162/100 DST 1662-77  
90" 7' M S C Email EP0-0 BHP  
10 Ø 1948 SEP 24 '58 TD 2059 skel

D & A

Co. No. Sec. T. R.