


Section 5 Township 35 Range 4E

Well No. #3 Moore

Company Smitherman & Cohen

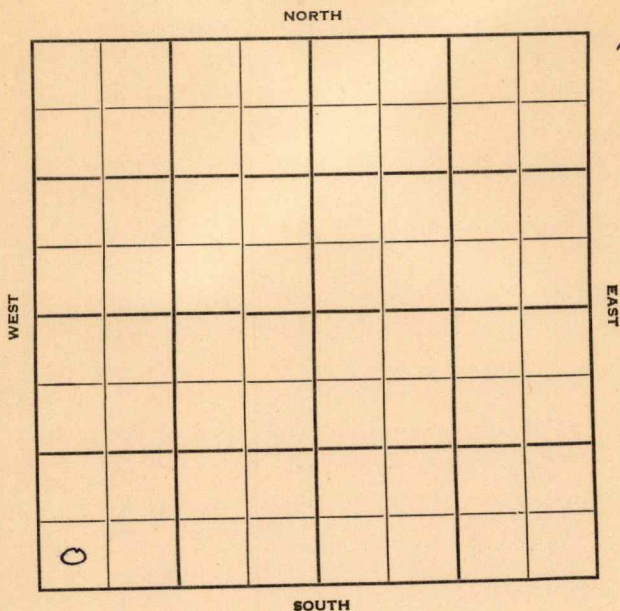

Cowley

KANSAS

Sec. 5 Twp. 35 R. 4E

Well No. #3 Moore Farm

Smitherman & Cohen Company

Contractor

Ft. from N. Line

330


Ft. from S. Line

Ft. from E. Line

330

Ft. from W. Line

SW SW SW

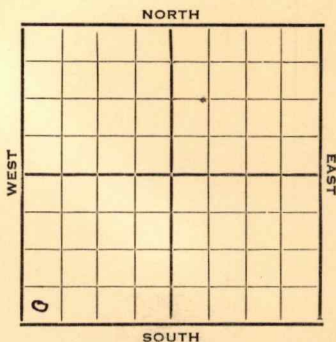

1952 Elev. 1135'

REPORT

5/28

Location

7/23

Spud 6-16-52

Oil Well

TD 3298

8" @ 65'

Stal. 2125

Layton 2540

Bart. 3285

5" @ 3285

Miss. 3293

TD 3298 3-hydro

Comp 100 bopd

COMPLETED

County	Cowley		State	Kansas
Sec.	5	(Blk. Twp.)	35	(Sur. Rge.) 4E Map No.

Sec. **5** (Blk.) **35** (Sur.) **4E** Map No.

Operator **Smitherman & Cohen**

Well No. 3 Farm Moore

Elev.	1135	Location	SW SW SW
-------	------	----------	----------

0

FIRST REPORT

330 Ft. From S Line SW

330 Ft. From W Line Quarter

1st. Report MAY 28 1952

Completion

Remarks

Spudding Date

Drlg. Data

Location

J. G. McGEREE

