


Sawley
Map No. **KANSAS** Sec. *5* Twp. *35*^S R. *4*^E
Well No. *1- Reynolds* Farm
Company *3*

NORTH

WEST

EAST

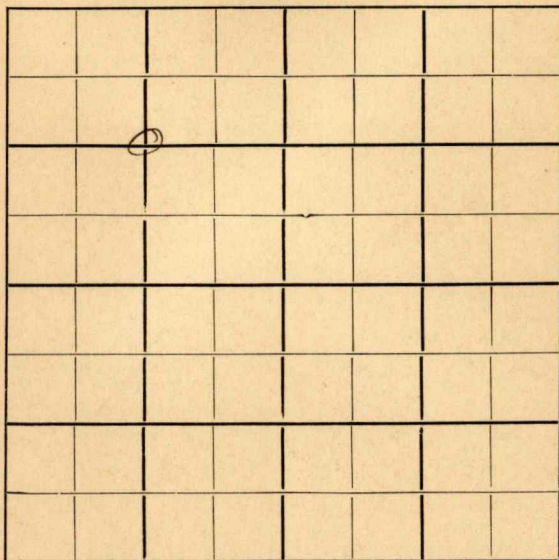

SOUTH

Location.....

Drilling Remarks

Rig Up.....

Drilling Remarks

RECORD

Cased.....in.....ft.

Sand.....

Gas.....

Oil.....

Total Depth.....

PRODUCTION

1st 24 hrs. Nat.....

1st 24 hrs. after shot.....

Gas.....cu. ft.....

Dry Hole.....

Abandoned.....

Map No. Sec. Twp. R.

Well No. Farm


..... Company

..... Ft. from N. Line

..... Ft. from S. Line

..... Ft. from E. Line

..... Ft. from W. Line

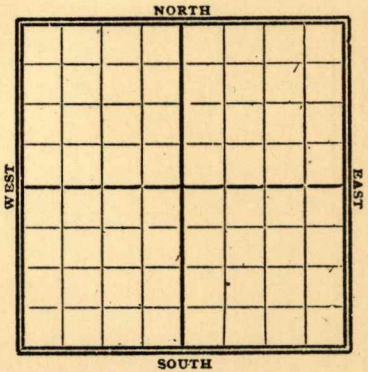

Date

REPORT

Gypsy Records
Abd T.D. 755'

K2 MAP NO. **KANSAS** SEC. 5 TWP. 35S R. 1E

WELL NO. 1, Reynolds

COMPANY

CONTRACTOR

SECTION PLAT

ABANDONED

FT. FROM N. LINE

FT. FROM S. LINE

FT. FROM E. LINE

FT. FROM W. LINE

no record

LOCATION

RIG UP

DRILLING AND REMARKS:

RECORD

CASED IN. FT.

SAND

GAS

OIL

TOTAL DEPTH 755

PRODUCTION

1ST 24 HRS. NAT.

1ST 24 HRS. AFTER SHOT

GAS Cu. Ft.

DRY HOLE ☒

ABANDONED ☒

DATE

192

SCOUT