
FORM 51 25M 8-50 WESTERN Cowley KANSAS

Section 6 Township 35 Range 4E

Well No. #4 Bergkamp

Company Smitherman & Cohen

15

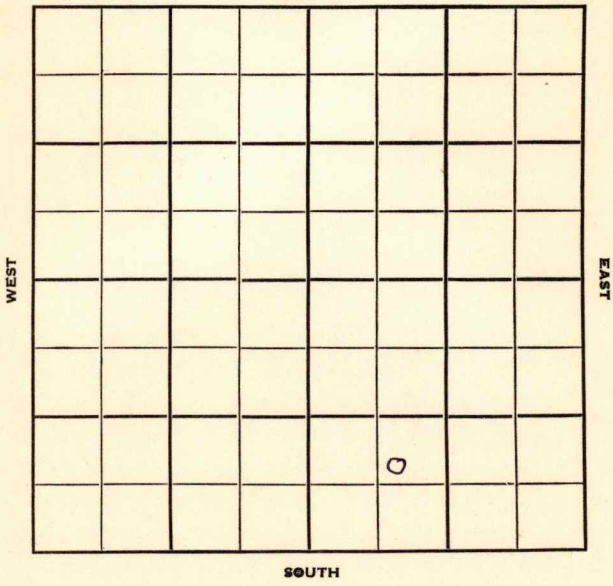

FORM 252-B
10M 8-51 TPCO.

Cowley

KANSAS

Sec. 6 Twp. 35 R. 4E

Well No. #4 Bergkamp Farm

Smitherman & Cohen Company

Contractor

Bergkamp


Ft. from N. Line

800 Ft. from S. Line

Ft. from E. Line

940 Ft. from W. Line

NE SW SE

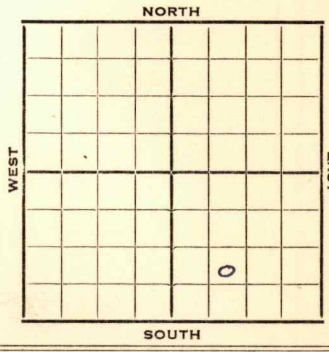

1952 Elev. 1116' REPORT

4/2
4/23

Location
Spud 4-6-52
Oil Well TD 3317'
8" @ 65'
Bart. 3258-86 Miss. 3315
TD 3317 5" @ 3317 29/ 3258-63
Hydro F/ 240 bo 6 hr.
Comp. F/ 516 bopd

COMPLETED

FORM 275 FOR SALE BY KANSAS BLUE PRINT CO.


County Cowley State Kansas

Sec. 6 (Blk. Twp.) 35 (Sur. Rge.) 4E Map No.

Operator Smitherman & Cohen

Well No. 4 Farm Bergkamp

Elev. 1116 Location NE SW SE

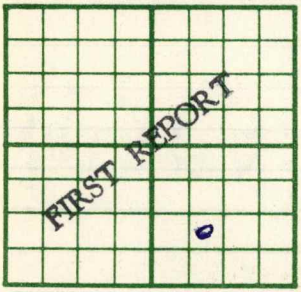

800 Ft. From S Line SE

940 Ft. From W Line Quarter

1st. Report APR 2 1952

Completion

Remarks

Spudding Date

Drlg. Data Bergkamp

Location

J. G. McGEHEE

FORM 275 FOR SALE BY KANSAS BLUE PRINT CO.

County Cowley State Kansas

Sec. 6 (Blk. Twp.) 35 (Sur. Rge.) 4E Map No.

Operator Smitherman & Cohen

Well No. 4 Farm Bergkamp

Elev. 1116 Location NE SW SE



800 Ft. From S Line SE

940 Ft. From W Line Quarter

1st. Report

Completion APR 23 1952

Remarks Bergkamp Pool

Spudding Date 4-6-52

Drlg. Data Oil well TD 3317

8" @ 65 Bart. 3258-86 Miss. 3315

TD 3317 5" @ 3317 29/ 3258-63

Hydro. F/ 240 bo 6 hr.

Comp. F/ 516 bopd

J. G. McGEHEE