
FORM 51 25M 8-50 WESTERN Cowley KANSAS

Section 6 Township 35 Range 4E

Well No. #5 Bergkamp

Company Smitherman & Cohen

16

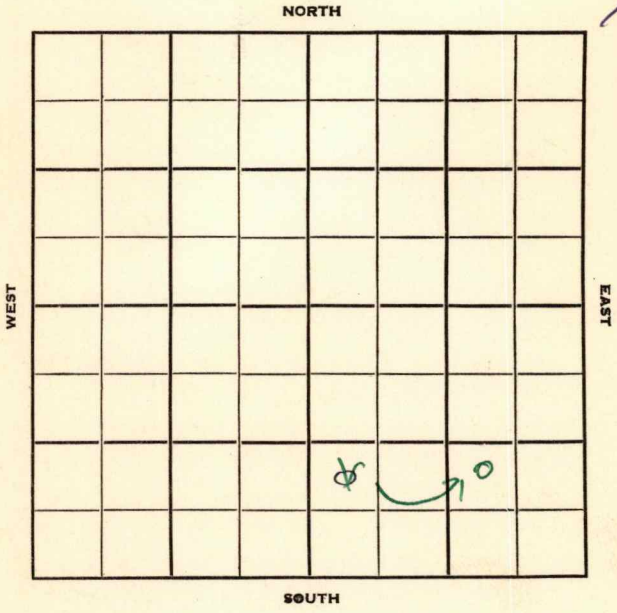

FORM 252-B
10M 8-51 TPCO.

Cowley KANSAS

Sec. 6 Twp. 35 R. 4E

Well No #5 Bergkamp Farm

Smitherman & Cohen Company

Contractor


Ft. from N. Line

990' Ft. from S. Line

990 Ft. from E. Line

~~330'~~ Ft. from W. Line

NW ~~SW~~ SE

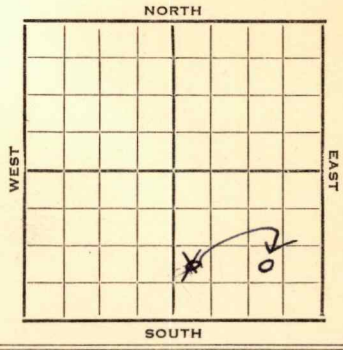

1952	Elev. 1095' REPORT
4/9 5/13	Set Surf WOR Spud 4-14-52 Oil Well TD 3240' 8" @ 81 Stal. 2200' Layton 2600 Bart. 3233-40 5" @ 3238' CO to 3240 Hydro. F/ 35 boph Comp. 528 bopd COMPLETED

FORM 275 FOR SALE BY KANSAS BLUE PRINT CO.

County Cowley State Kansas

Sec. 6 (Blk. Twp.) 35 (Sur. Rge.) 4E Map No.

Operator Smitherman & Cohen

Well No. 5 Farm Bergkamp

Elev. Location NW SW SE



990 Ft. From S Line SE

330 Ft. From W Line Quarter

1st. Report APR 9 1952

Completion

Remarks

Spudding Date

Drlg. Data

Set Surf W.O.R.

J. G. McGEHEE

Form 26 200 Bks. 11-49 Petrol Cowley . Kansas

Map No. _____ Sec. 6 Twp. 35 R. 4E


Well No. 5 Bergkamp

Smitherman & Cohen Company

Contractor

NW SE SE

SECTION PLAT

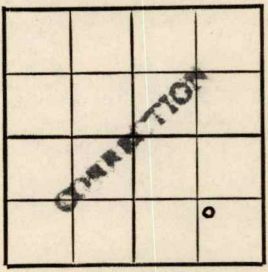

_____ Ft. from N. Line

990 Ft. from S. Line

990 Ft. from E. Line

_____ Ft. from W. Line

Location _____

Rig up _____

Drilling and Remarks:

Reported

NW SW SE

RECORD

Cased _____ in., _____ ft.

Sand _____

Gas _____

Oil _____

Total Depth _____

PRODUCTION

1st 24 hrs. Nat. _____

1st 24 hrs. after shot _____

Gas _____ Cu. Ft.

Dry Hole _____

Abandoned _____

Date

APR 1 6 1952

_____ 19 _____

J. G. McGEHEE

_____ Scout

FORM 275 FOR SALE BY KANSAS BLUE PRINT CO.

County Cowley State Kansas

Sec. 6 (Blk. Twp.) 35 (Sur. Rge.) 4E Map No.

Operator Smitherman & Cohen

Well No. 5 Farm Bergkamp

Elev. 1095 Location NW SE SE



990 Ft. From S Line SE

990 Ft. From E Line Quarter

1st. Report

Completion MAY 14 1952

Remarks

Spudding Date 4-14-52

Drlg. Data Oil well TD 3240

8" @ 81 Stal. 2200 Layton 2600

Bart. 3233-40 5" @ 3238 CO to 3240

Hydro. F/ 35 boph Comp. 528 bopd

J. G. McGEHEE