


Section 6 Township 35 Range 4 E

Well No. # 7 Bergkamp

Company L. C. Smitherman et al

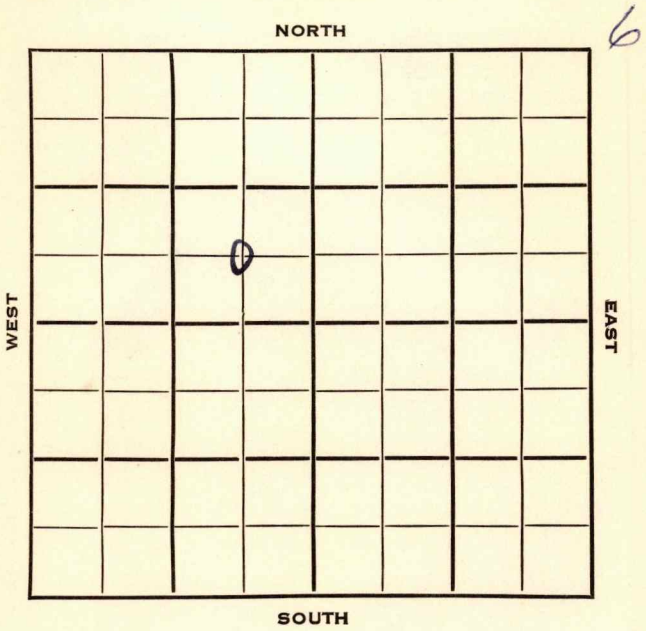

Cowley

KANSAS ✓

Sec. 6 Twp. 35 R. 4E

Well No. #7 Bergkamp Farm

L.C. Smitherman et al Company

Smitherman & Groves Contractor

Bergkamp Pool


_____ Ft. from N. Line

660 Ft. from S. Line

660 Ft. from E. Line

_____ Ft. from W. Line

C SE NW

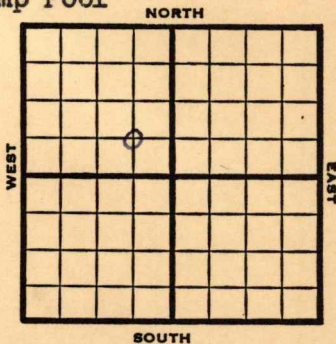

1953 Elev. 1066' REPORT

8/26 C & P

12/16

Oil Well

TD 3221'

Bart 3216'

TD 3221'

5" @ 3216'

DD 3230'

sd-oil-frac P & F / 10 boph 2% wtr.

Comp 58 bopd 44% wtr.

COMPLETED

County Cowley State Kansas

Sec. 6 (Blk. Twp.) 35 (Sur. Rge.) 4E Map No.

Operator L. C. Smitherman etal.

Well No. 7 Farm Bergkamp

Elev. _____ Location C SE NW

660 Ft. From S Line NW

660 Ft. From E Line Quarter

1st. Report AUG 26 1953

Completion _____

Remarks _____

Smitherman & Groves - Contr

Spudding Date _____

Drig. Data Bergkamp Pool

Cellar & pits

County Cowley State Kansas
 Sec. 6 (Blk.) 35 (Sur.) 4E Map No.
 Operator L. C. Smitherman et al.
 Well No. 7 Farm Bergkamp
 Elev. 1066 Location C SE NW



660 Ft. From S Line NW
660 Ft. From E Line Quarter
 Ist. Report _____
 Completion DEC 16 1953
 Remarks Bergkamp Pool
Smitherman & Groves- Contr
 Spudding Date _____

Drlg. Data Oil well TD 3221
Bart. 3216 TD 3221 5" @ 3216 DD 3230
sd-oil-frac P & F/ 10 boph 2% wtr.
Comp. 58 bopd 44% wtr.

J. G. MCGEHEE