Cowley **KANSAS**

SECTION 6 TOWNSHIP 35 RANGE 4E

WELL NO. #10 Bergkamp

COMPANY Smitherman

SW SW NE-KGS
// Bml

NORTH ~~Nw~~ ~~NW NW SE~~

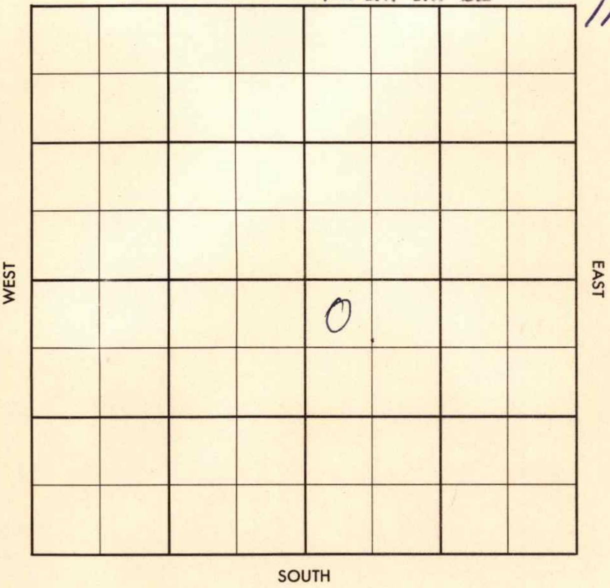
WEST
EAST
O
SOUTH

FORM 504-3 SUNRAY

FORM 513 SUNRAY

County Cowley Elev.

Sec. 6 Twp. 35 Rge. 4E

Company Smitherman

FarmName Bergkamp No. 10

TOPS	DEPTH	LOG	DATUM
Anh.			
Tp.			
H.			
Tr.			
Dg.			
Bl.			
L.			
K.C.			
B.K.C.			
Ce.			
C.			
M.			
M.			
K.			
Mz.			
Mg.			
V.			
S.			
S.			
A			
R.			
PE.			
G.			
T.D.			

Loc. in Sec.
~~NW NW SE~~
SW SW NE
'KGS/Onl

Geol.

Contr.
Serobee Tools

Pool
Bergkamp

FIRST REPORT
o
MAR 13 '57

Date Comm. 3-8-57

8" @ 122/125, Drlg. 1830

~~29~~

Co.
Lse.
No.
Sec.
T.
R.

CORRECTION

FORM 513 SUNRAY

County Cowley Elev. 1064

Sec. 6 Twp. 35 Rge. 4E

Company Smitherman

Farm Name Bergkamp No. 10

TOPS	DEPTH	LOG	DATUM
Anh.			
Tp.			
H.			
Tr.			
Dg.			
Bl.			
L.			
K.C.			
B.K.C.			
Ce.			
C. Bartl	3229		
M.			
M.			
K.			
Mz.			
Mq.			
V.			
S.			
S.			
A			
R.			
P€.			
G.			
T.D.	3241½		

Loc. in Sec.
~~NW NW SE~~
~~[illegible]~~
~~NWNWNWSE~~
SWSWNE
1163/DRL

Geol.

Contr.
Serobee Tools

Pool
Bergkamp

COMPLETE
APR 17 '57

Date Comm. 3-8-57

8" @ 122/125, Drlg. 1830 20 '57

Rng 5½ @ 3230/85 MAR 27 '57 WOCT

APR 3 '57 APR 10 '57 CO 3241½ TD

S 2 Goph + 1 Bwph Frac

6x3 S 50 Bo + 20 Bw

in 3 hrs POP APR 17 '57 P 100

Bopd + 50 Bwpd

P. 25 Bopd + 15 Bwpd

Co.

Lse.

No.

Sec.

T.

R.