


Cowley

KANSAS

SECTION 6 TOWNSHIP 35 RANGE 4E

WELL NO. #11 Bergkamp

COMPANY Smitherman

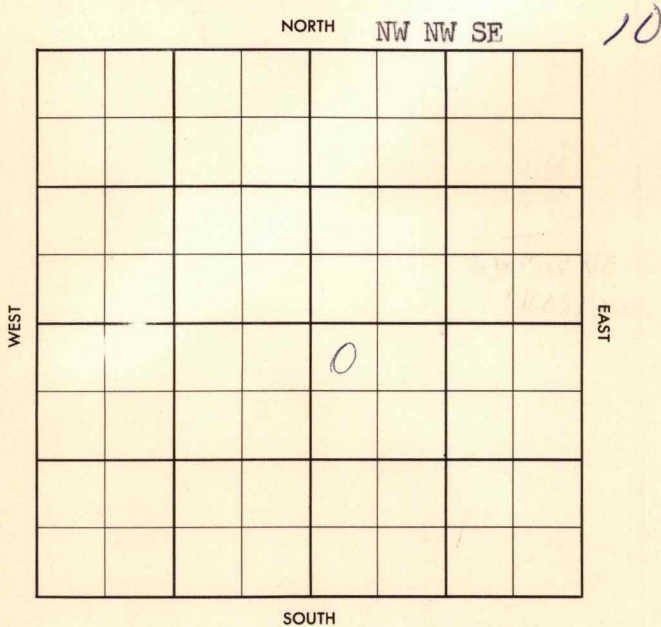

County Cowley Elev. _____
 Sec. 6 Twp. 35 Rge. 4E
 Company Simtherman
 Farm Name Bergkamp No. 11

TOPS	DEPTH	LOG	DATUM	Loc. in Sec.
Anh.				NW NW SE
Tp.				
H.				
Tr.				
Dg.				
Bl.				
L.				Geol. _____
K.C.				Contr. _____
B.K.C.				SeRoBee Tools
Ce.				
C.				Pool
M.				Bergkamp
M.				
K.				
Mz.				
Ma.				
V.				
S.				
S.				
A.				
R.				
PE.				
G.				
T.D.				

FIRST REPORT
 0
 MAR 27 '57

Date Comm. 3-20-57
8" @ 124, Drlg. 2400

~~29~~

Co.
 Use.
 No.
 Sec.
 T.
 R.

County Cowley Elev. 1070
 Sec. 6 Twp. 35 Rge. 4E
 Company Smitherman
 Farm Name Bergkamp No. 11

Co.

TOPS	DEPTH	LOG	DATUM	Loc. in Sec.
Anh.				W/2 NW SE
Tp.				
H.				
Tr.				
Dg.				
Bl.				
L. <u>Bartl.</u>	<u>3217</u>			Geol.
K.C.				Contr.
B.K.C.				SeRoBee Tools
Ce.				Pool
C.				Bergkamp
M.	<u>g</u>			<div style="border: 1px dashed black; padding: 5px; text-align: center;"> <p>COMPLETE</p> <p>MAY 29 '57</p> </div>
M.				
K.				
Mz.				
Me.				
V.				
S.				
S.				
A.				
R.				
PE.				
G.				
T.D.	<u>3250</u>			

L. Sec.

No.

Sec.

T.

R.

Date Comm. 3-20-57
8" @ 124, Drlg. 2400 5 1/2 @ 3250, WOCT
POF (May 29, '57) X Bartl. 3217
MICT CO 3240 48 / 3219-31 tid
1 Bopd Frac 10 x 5 Pop. P.
35 Bopd + 30% wtr complete
25 Bopd + 30% wtr.