


KANSAS

Barton

Section 30 Township 16 Range 11W

Well No. #4 South Deser

Company Springer etal.

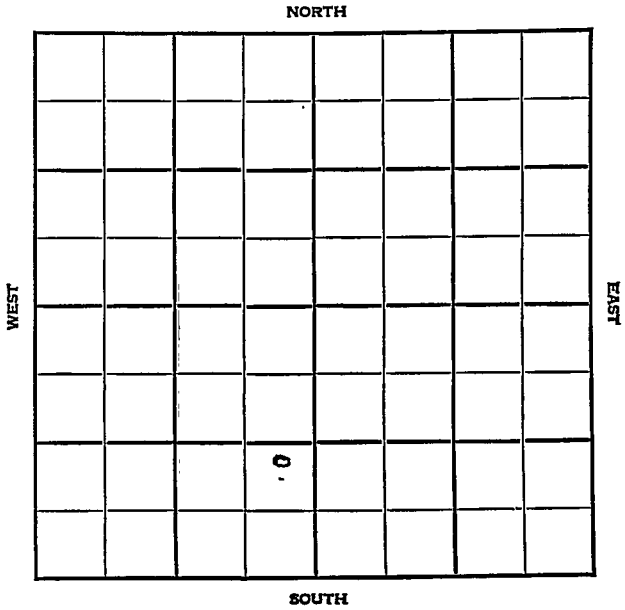

KANSAS

Barton

Sec. 30 Twp. 16 R. 11W

Well No. #4 South Oeser Farm
Springer et al Company

Kraft-Prusa Pool

_____ Ft. from N. Line

1173'


_____ Ft. from S. Line

330'

_____ Ft. from E. Line

_____ Ft. from W. Line

NE SE SW

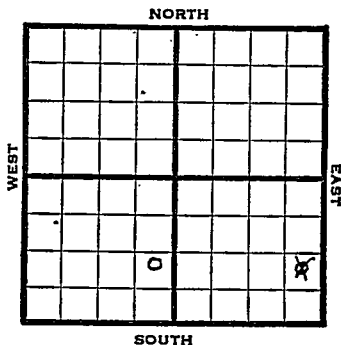

1948 Elev. 1929' REPORT

- 2/4 RUR
- 2/11 10" @ 338'
Drlg. 1585'
- 2/18 Drlg. 2906'
- 2/25 Topeka 2680'
Lansing 3054'
TD 3145'
8" @ 3141'
RUST
- 3/3 "
- 3/10 "
- 3/17 "
- 3/24 "
- 3/31 "
- 4/7 "
- 4/14 "
- 4/21 TD 3151'
Swb 2 W PH
Plug 3108'
48 shots 3085-91
4000 Acid
- 4/28 "

(Over)

1948

5/5 Lans. 3054'
7" @ 3141'
Perf.
400 Acid
Pump 167 oil Pot.
Gr. 42°
TD 3145'

COMPLETED

Map No. _____ Sec. 30 Twp. 16 R. 11W

Well No. 4 South Oeser

Springer etal. Company

FIRST REPORT Contractor

NE SE SW

SECTION PLAT

_____ Ft. from N. Line

1173 Ft. from S. Line

330 Ft. from E. Line

_____ Ft. from W. Line

Barton County

Location _____

Rig up _____

Drilling and Remarks:

R U R

RECORD

Cased _____ in., _____ ft.

Sand _____

Gas _____

Oil _____

Total Depth _____

PRODUCTION

1st 24 hrs. Nat. _____

1st 24 hrs. after shot _____

Gas _____ Cu. Ft.

Dry Hole _____

Abandoned _____

Date

FEB 4 1948 19

S. J. LEWIS Scout

Map No. 5 J Sec. 30 Twp. 16 R. 11W

Well No. 4 South Oeser

Springer etal. Company

COMPLETE

Contractor

NE SE SW

E 11929
SECTION PLAT

 Ft. from N. Line

1173 Ft. from S. Line

330 Ft. from E. Line

 Ft. from W. Line

	△		

Barton County

Location

Rig up

Drilling and Remarks:

Lans 2054
7" casing
Perf.
400 acid
Prod. 167 oil Prod
#2 2/28

RECORD

Cased in., ft.

Sand

Gas

Oil ✓

Total Depth 2340

PRODUCTION

1st 24 hrs. Nat.

1st 24 hrs. after shot

Gas Cu. Ft.

Dry Hole

Abandoned

Date

MAY 5 1948 19

S. J. LEWIS Scout