


Section 30 Township 16 Range 11-W

Well No. #7 South Oeser

Company Springer et al

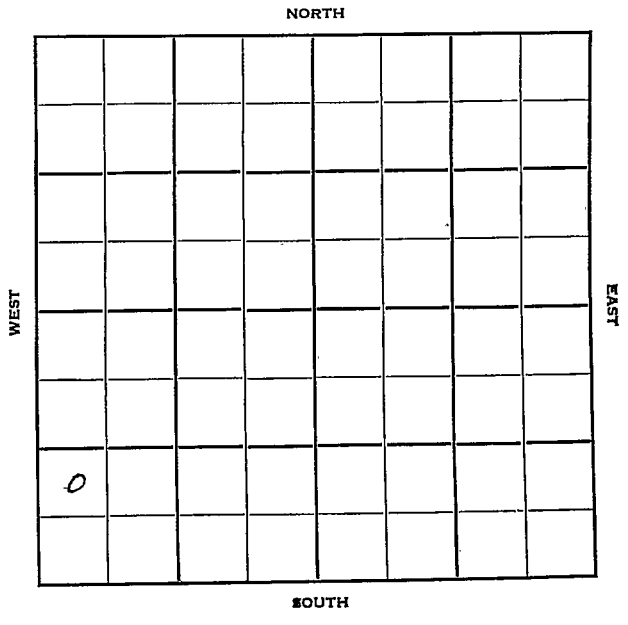

Sec. 30 Twp. 16 R. 11W

Well No. #7 South Oeser Farm

Springer-et al Company

Sterling Drlg. - Contr. Contractor

Kraft-Prusa Pool


Ft. from N. Line

990' Ft. from S. Line

Ft. from E. Line

330' Ft. from W. Line

NW SW SW

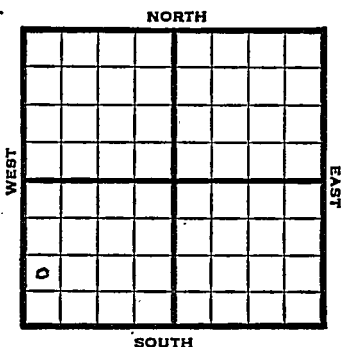

1950

Elev. 1913' REPORT

10/18

Spud 10-10-50
8-5/8" @ 315'
Anhy 750-80'
Drlg. 2237'

11/15

Spud 10-10-50
Oil Well TD 3295'
8-5/8" @ 315'
Anhy 750-80'
Top 2687'
SSO 2874-83
Heeb. 2927
Dodge 2942'
Douglas Sand 2972-87
DST 2970-80 opn 1 hr
Rec. 30' gcm
Br. Lime 3022
Lans. 3036'
Qts. 3260-72 5" @ 3260'
DD 3295 1 bo overnite 12/3260-72
SP 3180 24/3123-28 FU 1430' oil
14 hr. S/3 BOPH Comp. 107 BOPD

COMPLETED

