DX 78-1


Cowley KANSAS

Section 8 Township 35 Range 4 E

Well No. # 6 Broce

Company W. L. Lamberton

4

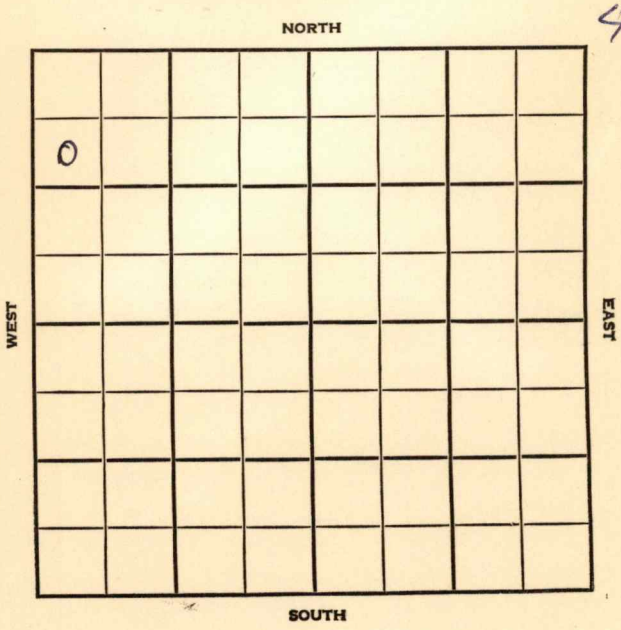

Cowley KANSAS

SEC.	TWP.	R.
8	35	4E

WELL NO.

6 Broce FARM

COMPANY

W. L. Lamberton

CONTRACTOR

Jones & Owens

Bergkamp Bool


990 Ft. from N. Line

Ft. from S. Line

Ft. from E. Line

330 Ft. from W. Line

SW NW NW

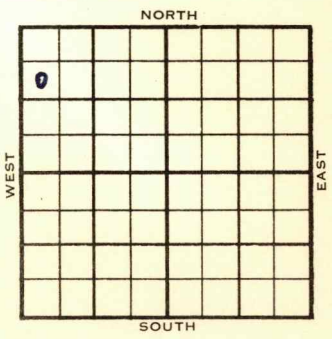

1954	ELEVATION 1160'	REPORT
11/10	Pipe Set	
12/8	Spud 11-12-54 Oil well TD 3325 8" @ 106 Br. lime 3073 Stal. 3162 KC 2495 Layton 2567 Cherokee 3073 Bart 3291 TD 3325 5" @ 3292 CO to 3325 sd-oil-frac F/50 BO 8 hr. Comp. 25 BOPD	
	COMPLETED	

DX-78

FORM 275 FOR SALE BY KANSAS BLUE PRINT CO.

County Cowley State Kansas

Sec. 8 (Blk. Twp.) 35 (Sur. Rge.) 4E Map No.

Operator W. L. Lamberton

Well No. 6 Farm Broce

Elev. 1160 Location SW NW NW



990 Ft. From N Line NW

330 Ft. From W Line Quarter

1st. Report NOV 10 1954

Completion

Remarks

Jones & Owens - Contr.

Spudding Date

Drlg. Data Bergkamp Pool

Pipe set

FABEN GILSTRAP

FORM 275 FOR SALE BY KANSAS BLUE PRINT CO.


County Cowley State Kansas

Sec. 8 (Blk. Twp.) 35 (Sur. Rge.) 4E Map No.

Operator W. L. Lamberton

Well No. 6 Farm Broce

Elev. 1160 Location SW NW NW

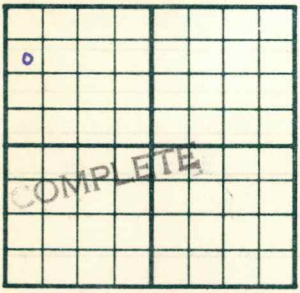

990 Ft. From N Line NW

330 Ft. From W Line Quarter

1st. Report

Completion DEC 8 1954

Remarks Bergkamp Pool

Jones & Owens - Contr.

Spudding Date 11-12-54

Drlg. Data Oil well TD 3325

8" @ 106 Br. lime 3073 Stal. 3162

KC 2495 Layton 2567 Cherokee 3073

Bart. 3291 TD 3325 5" @ 3292

CO to 3325 sd-oil-frac F/ 50 bo 8 hr.

Comp. 25 bopd

FABEN GILSTRAP