

KANSAS

Barton

FORM 51 5M 10-41 PETROL

Section 30 Township 16 Range 11-W

Well No. #2 Oeser North

Company Geo. Johnston et al

NORTH Kraft Prusa Pool

			0				

SOUTH

WEST EAST


Sec. 30 Twp. 16 R. 11-WWell No. #2 Oeser North Farm

Geo. Johnston et al Company

(Kraft Prusa)

330 Ft. from N. Line Ft. from S. Line330 Ft. from E. Line Ft. from W. Line

Elev. 1918

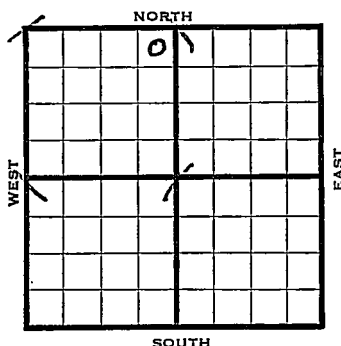

1942

REPORT

7/1	R.U. Cable tools.		
7/8	13" - 497'	10" - 760'	
	Anhy. 755'	Drlg. 910'	
7/15	Drlg. 2030'		
7/22	8" @ 2120	Drlg. 2675'	
7/29	Drlg. 3000'		
8/5	Lans 3057	Pay 3064-68 TD	
	7" - 3057 WOC		
8/12	1800' oil	5000 acid	
8/19	Temp. Pot. 72'		
8/27	" "	"	
9/2	" "	"	
9/9	" "	"	
9/16	" "	"	
9/23	" "	"	
9/30	TD 3068 Shut in		
10/7	" "		
10/14	Lans. 3057		
	7" - 3057		
	4900 acid		
	Pump 248 Pot.		
	Gravity 43.6		
	T.D. 3068'		

COMPLETED

Barton

KANSAS

Map No. 55 Sec. 30 Twp. 16 R. 11WWell No. 2 Oeser North

Geo. Johnston et al.

Company


FIRST REPORT

Contractor

NE NW

330 Ft. from N. Line Ft. from S. Line330 Ft. from E. Line Ft. from W. Line

SECTION PLAT

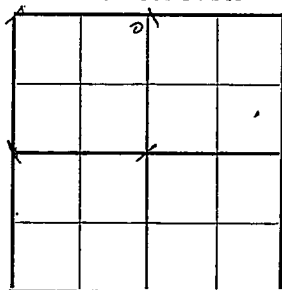

KRAFT PRUSA POOL

RECORD

Location Rig up

Drilling and Remarks:

Cased in., ft.Sand Gas Oil Total Depth

PRODUCTION

1st 24 hrs. Nat. 1st 24 hrs. after shot Gas Cu. Ft.Dry Hole Abandoned Rigging up
cable tools

Date


JUL 1 1942 19S. J. LEWIS

Scout

Map No. 55 Sec. 30 Twp. 16 R. 11WWell No. 2 Oeser NorthGeo. Johnston et al. CompanyCOMPLETED Contractor

NE NW

SECTION PLAT

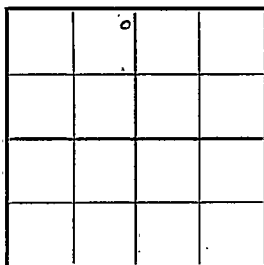330 Ft. from N. Line Ft. from S. Line330 Ft. from E. Line Ft. from W. Line

KRAFT PRUSA POOL

Location Rig up

Drilling and Remarks:

Loss 30577" C 30574900 acidPump 248 1/2 ft43 1/2 Gr

RECORD

Cased in., ft.Sand Gas Oil Total Depth 3068

PRODUCTION

1st 24 hrs. Nat. 1st 24 hrs. after shot Gas Cu. Ft.Dry Hole Abandoned

Date

OCT 14 1942

19

S. J. LEWIS Scout