DX 78-1 X Cowley


KANSAS

Section 8 Township 35S Range 4E

Well No. #8 Broce

Company L. C. Smitherman

5

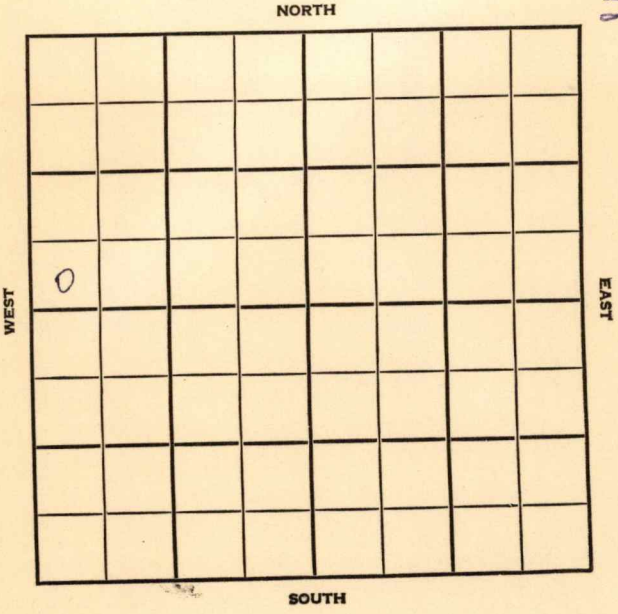

Cowley KANSAS

SEC.	TWP.	R.
8	35	4E

WELL NO.

#8 Broce FARM

COMPANY

L.C. Smitherman

CONTRACTOR

Co. #2

Bergkamp


_____ FT. FROM N. LINE

_____ FT. FROM S. LINE

_____ FT. FROM E. LINE

_____ FT. FROM W. LINE

SW SW NW

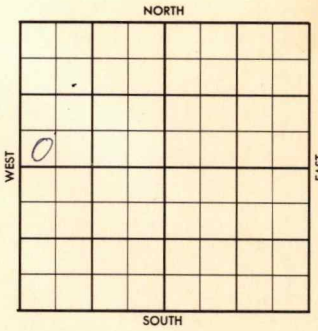

ELEVATION	REPORT
1956	
8-1	Location

FORM 504-5 SUNRAY

FORM 513 SUNRAY

County Cowley Elev. 1139

Sec. 8 Twp. 35S Rge. 1E

Company J. C. Smitherman

Farm Name Broce No. 8

TOPS	DEPTH	LOG	DATUM
Anh.			
Tp.			
H.			
Tr.			
Dg.			
Bl. Bartl	3287		
L.			
K.C.			
B.K.C.			
Ce.			
C.			
M. chat	3317		
M.			
K.			
Mz.			
Mo.			
V.			
S.			
S.			
A			
R.			
P€.			
G.			
T.D.	3330		

Loc. in Sec. SW SW NW

Geol.

Contr. Co. #2

Pool Bergkamp

COMPLETE

JAN 19 '57

Date Comm.

Loc. AUG 8 '56 AUG 15 '56 AUG 22 '56 ✓ SEP 5 '56 AUG 29 '56 SEP 12 '56 SEP 19 '56 SEP 26 '56 OCT 3 '56 OCT 10 '56 ✓ OCT 17 '56 ✓ OCT 24 '56 OCT 31 '56 ✓ NOV 7 '56 ✓ NOV 13 '56 ✓ NOV 21 '56 ✓ NOV 28 ✓ DEC 5 '56 ✓ DEC 12 '56 DEC 19 '56

12-11-56 857 CO ⌀2565

DEC 26 '56 5½@3330 JAN 2 '57 CO

JAN 9 '57 JAN 16 '57 CO 3310 24/3288

-94 34/3294-3303 Frac 6x3

Co. Lse. No. Sec. T. R.

FORM 513-1 SUNRAY

Flw 10 Boph no/w 8 hrs
Flw 35 Bopd no/wtr completo

FORM 513 SUNRAY

County Cowley Elev.

Sec. 8 Twp. 35S Rge. 4E

Company L. C. Smitherman

Farm Name Bryce No. 8

TOPS	DEPTH	LOG	DATUM
Anh.			
Tp.			
H.			
Tr.			
Dg.			
B.L.			
L.			
K.C.			
B.K.C.			
Ce.			
C.			
M.			
M.			
K.			
Mz.			
Mg.			
V.			
S.			
S.			
A			
R.			
P€.			
G.			
T.D.			

Loc. in Sec. SW SW NW

Geol.

Contr. Co. #2

Pool Bergkamp

FIRST REPORT

0

Date Comm. AUG 1 1956

Loc.

Co. Lse. No. Sec. T. R.

AUG 7 1956
R. G.