


KANSAS

Barton

Section 30 Township 16 Range 11W

Well No. #5 South Oeser

Company Springer etal.

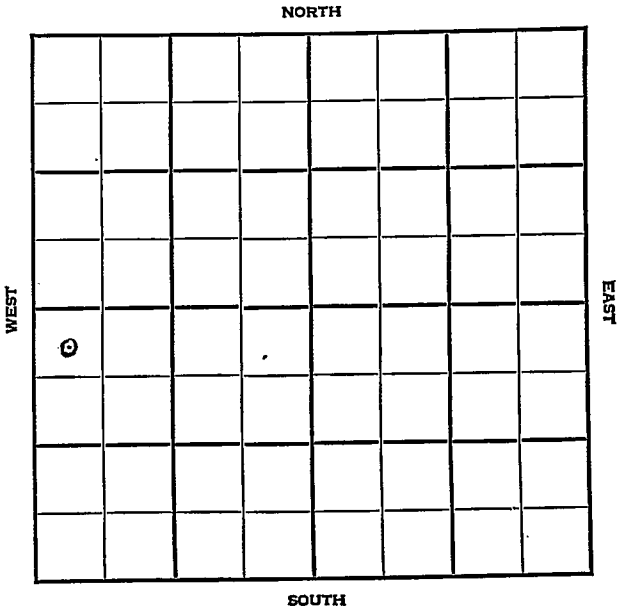

Sec. 30 Twp. 16 R. 11W

Well No. #5 South Oeser Farm

Springer et al Company

Kraft-Prusa


330 Ft. from N. Line

 Ft. from S. Line

 Ft. from E. Line

330 Ft. from W. Line

NW SW

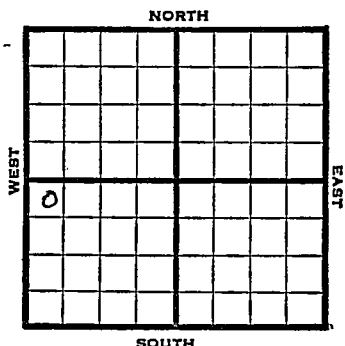

1948

Elev. 1924' REPORT

1/21

8" @ 334'

Drlg. 615'

1/26

Drlg 2655'

2/4

Lansing 3047'

Quartzite 3294'

3299' TD

5" @ 3296'

RUST

2/11

"

2/18

32 shots 2879-86'

500 acid

Swb 32 Oil 1 hr.

2500 acid

2/25

Swb 5 bbls oil PH, 5 hrs.

3/3

"

3/10

"

3/17

"

3/24

"

3/31

"

4/7

"

4/14

"

4/21

TD 3299'

OVER

1948

4/28 Lans. 3047'
Quartzite 32948
5" @ 3296'
Perf Lans.
3000 Acid
Pump 38 oil Pot.
Gr. 42°
TD 3299'

COMPLETED

Map No. _____ Sec. 30 Twp. 16 R. 11W

Well No. 5 South Oeser

Springer etal. _____ Company

FIRST REPORT _____ Contractor

NW SW


SECTION PLAT

330 Ft. from N. Line

_____ Ft. from S. Line

_____ Ft. from E. Line

330 Ft. from W. Line

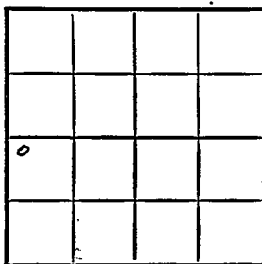

Barton County

Location _____

Rig up _____

Drilling and Remarks:

8" @ 334

drig, 615

RECORD

Cased _____ in., _____ ft.

Sand _____

Gas _____

Oil _____

Total Depth _____

PRODUCTION

1st 24 hrs. Nat. _____

1st 24 hrs. after shot _____

Gas _____ Cu. Ft.

Dry Hole _____

Abandoned _____

Date

JAN 21 1948

19

S. J. LEWIS Scout

Map No. 55 Sec. 30 Twp. 16 R. 11WWell No. 5 South OeserSpringer et al. Company


COMPLETE

Contractor

NW SW

E. 11924

SECTION PLAT

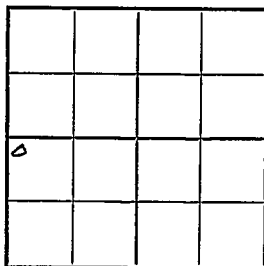330 Ft. from N. Line Ft. from S. Line Ft. from E. Line330 Ft. from W. Line

Barton County

Location Rig up

Drilling and Remarks:

Lane 3047Quartzite 32845" @ 3296Prof Lane.8000 acidPump & Soil Pt42 2 8

RECORD

Cased in., ft.Sand Gas Oil Total Depth 3299

PRODUCTION

1st 24 hrs. Nat: 1st 24 hrs. after shot Gas Cu. Ft.Dry Hole Abandoned

Date

APR 28 1948

19

S. J. LEWIS

Scout