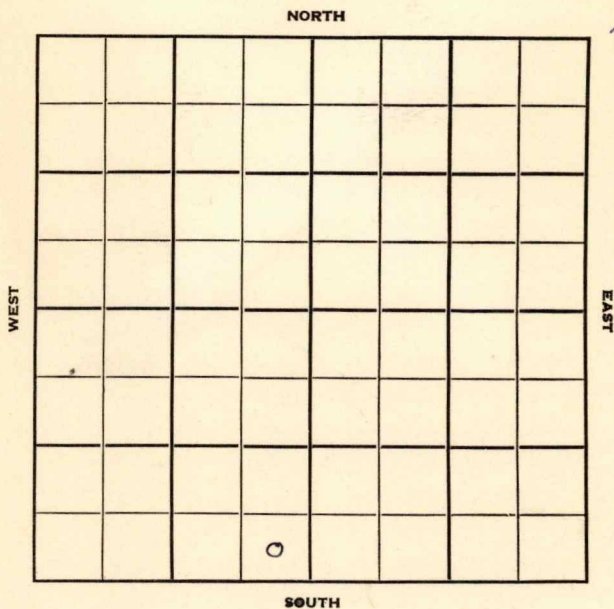


Section 8 Township 35 Range 4EWell No. #2 KlinkCompany Smitherman & Cohen

Cowley

Sec. 8 Twp. 35 R. ~~KANSAS~~ E

Well No. #2 Klink Farm

Smitherman & Cohen Company

Contractor


Ft. from N. Line

330' Ft. from S. Line

330' Ft. from E. Line

Ft. from W. Line

SE SE SW

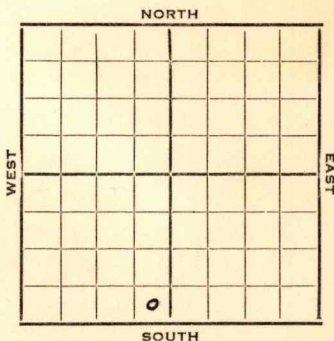

1952 **Elev. 1212'**

R E P O R T

4/9 Set Surf WOR
6/4 Spud 5-10-52
Oil Well TD3360'
8" @ 56 **Bart. 3337'** TD 3341
5" @ 3337' DD 3360' Hydro.
Comp. 159 bopd

COMPLETED

County Cowley State Kansas

Sec. 8 (Blk.) 35 (Sur.) 45 Map No.

Operator Smitherman & Cohen

Well No. 2 Farm Klink

Elev.	Location	SE	SE	SW
-------	----------	----	----	----

330 Ft. From S Line SW

330 Ft. From E Line Quarter

1st. Report APR 9 1952

Completion

Remarks

Spudding Date

Drlg. Data

Set surf. W.O.R.

J. G. McGEHEE

