

KANSAS


FORM 51 5M 11-24 PETROL

Butler County

Section 3 Township 25 Range 5E

Well No. #33 Robinson

Company Deep Rock

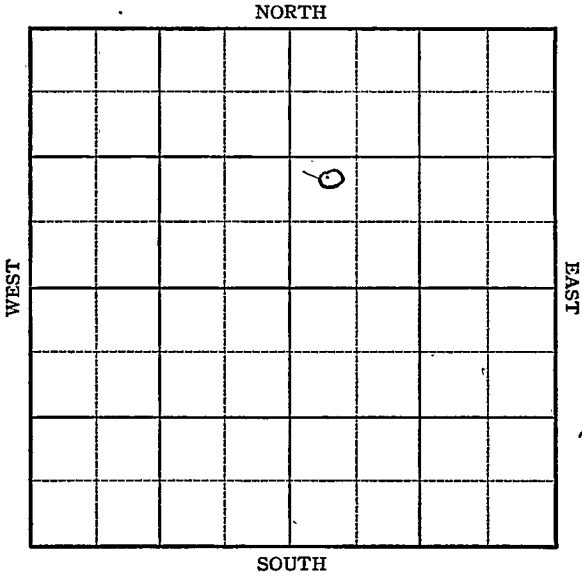

Sec. 3 Twp. 25 R. 5E

Well No. #33, Robinson Farm

Deep Rock Company


Miscellaneous

         Ft. from N. Line

1005 Ft. from S. Line

         Ft. from E. Line

475 Ft. from W. Line

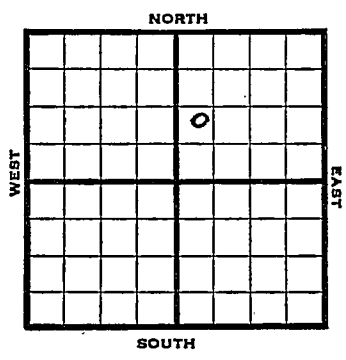

NW SW NE

1946 Elev. 1365 REPORT

6/12 Machine

6/18 12" @ 82  
Drlg 780'

6/26 Drlg 1705'  
10" @ 1335'

7/3 Lans 1671 KC 1943  
Miss 2365 Viola 2392  
8" @ 2395 RUST

7/9 TD 2395'

7/17 Viola 2392  
8" @ 2395  
TD 2445'  
Pump 210 Pot.  
Grav. 39

COMPLETED



Kansas Pool Name Miscellaneous  
 KANSAS  
 Map No. 1A Sec. 3 Twp. 25 R. 5E

Well No. 33 Robinson

Deep Rock

Company

**COMPLETED**

Contractor

NW SW NE

*E. 1365*  
SECTION PLAT

\_\_\_\_\_ Ft. from N. Line

1005 Ft. from S. Line

\_\_\_\_\_ Ft. from E. Line

475 Ft. from W. Line

		0	

Butler County

Location \_\_\_\_\_

Rig up \_\_\_\_\_

Drilling and Remarks:

*Vista 2392*  
*8" @ 2395*  
*Imp 210 Pt*

*09/92*

**RECORD**

Cased \_\_\_\_\_ in., \_\_\_\_\_ ft.

Sand \_\_\_\_\_

Gas \_\_\_\_\_

Oil \_\_\_\_\_

Total Depth 2445

**PRODUCTION**

1st 24 hrs. Nat. \_\_\_\_\_

1st 24 hrs. after shot \_\_\_\_\_

Gas \_\_\_\_\_ Cu. Ft.

Dry Hole \_\_\_\_\_

Abandoned \_\_\_\_\_

Date

JUL 17 1946

19

S. J. LEWIS

Scout