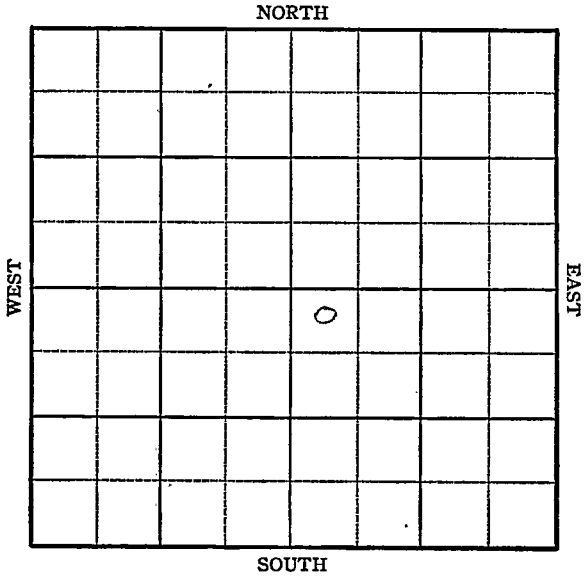


KANSAS

Butler

FORM 51 5M PETROL

Section 3 Township 25 Range 5EWell No. #9-29 S. RobinsonCompany Deep Rock

KANSAS

Butler

Sec. 3 Twp. 25 R. 5-E

Well No. #29 S. Robinson Farm

Deep Rock


Company

220 Ft. from N. Line

Ft. from S. Line

Ft. from E. Line

325 Ft. from W. Line

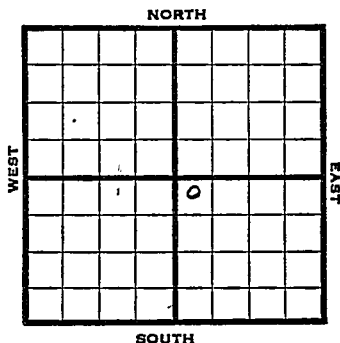

NW SE

1945 Elev. 1376 REPORT

11/21 Cable

11/28 12" @ 125
Drlg. 940

12/5 10" @ 1390
Lans 1690
KC 1971
Drlg. 2075

12/12 Viola 2449-2450
TD 2450
7" @ 2449

12/19 Viola 2449
7" @ 2449
500 acid.
TD 2450
Pump 45 Pot.
Grav. 38.0

COMPLETED

Kansas Pool Name Miscellaneous
KANSAS
 Map No. 14 Sec. 3 Twp. 25 R. 5E
 Well No. 29 S. Robinson

Deep Rock

Company

FIRST REPORT

Contractor

NW SE


SECTION PLAT

200 Ft. from N. Line

 Ft. from S. Line

 Ft. from E. Line

325 Ft. from W. Line

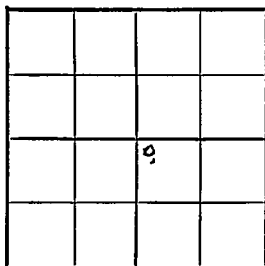

Butler County

Location

Rig up

Drilling and Remarks:

Cable

RECORD

Cased in., ft.

Sand

Gas

Oil

Total Depth

PRODUCTION

1st 24 hrs. Nat.

1st 24 hrs. after shot

Gas Cu. Ft.

Dry Hole

Abandoned

Date

NOV 21 1945

19

S. J. LEWIS Scout

Kansas Pool Name MiscellaneousMap No. K-14 Sec. 3 Twp. 25 R. 5EWell No. 9 Robinson

Deep Rock _____ Company

COMPLETED

Contractor

E11376

NW SE

SECTION PLAT

		6	

200 Ft. from N. Line

_____ Ft. from S. Line

_____ Ft. from E. Line

325 Ft. from W. Line*correct well No*
Butler County**RECORD**

Location _____

Cased _____ in., _____ ft.

Rig up _____

Sand _____

Drilling and Remarks:

Gas _____

Vista 2449

Oil _____

*7" C2449*Total Depth 2450*500 acia C***PRODUCTION***Pump 45 B.D.*

1st 24 hrs. Nat. _____

1st 24 hrs. after shot _____

Gas _____ Cu. Ft.

Dry Hole _____

Abandoned _____

28° Gr

Date

DEC 19 1945S. J. LEWIS Scout