

Barton

Section 31 Township 16 Range 11WWell No. 1 Janssen "B"Company Harms & Knight

NORTH

WEST

EAST

SOUTH

Barton KANSAS ✓

Sec. 31 Twp. 16 R. 11 WWell No. # 1 Janssen "B" FarmHarms & Knight

Company

Contractor

Ft. from N. Line

990


Ft. from S. Line

Ft. from E. Line

330

Ft. from W. Line

NW SW SE

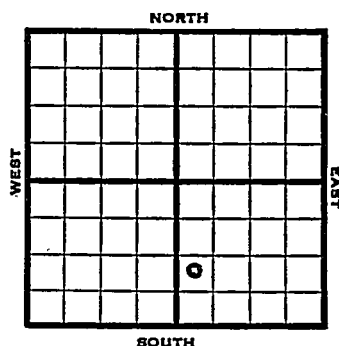

1952 Elev. 1881' REPORT

12/10 Cellar & Pits

12/11 C&P

12/18 C&P

12/25 C&P

1/1 C&P

1/8 8" @ 298 Ø2650

1/22 DST 2964-94, 1 hr, 180' O & GCM 103#
 Lans. 3053' Arb. 3319' RTD 3326
 5" @ 3324'

1/29 NR

2/5 CO 3326' 500 A FU 150' oil 1/2 hr.
 S/8 BOPH 12 hrs. POP

2/12 NR

2/19 NR

2/26 "

3/12 NR

3/19 NR

3/25 Oil Well

TD 3326

8" @ 298

DST 2964-94, opn 1 hr., rec.
 180' o & gcm, 103#

Lans 3053, Arb. 3319

TD 3326

5" @ 3324

OVER

#1 Janssen "B"
(Information Brought Forward)


1953
3/25

CO to 3326, 500A
FU 150' oil $\frac{1}{2}$ hrs.,
S/8 boph 12 hrs.
P/ 50 bopd
Comp. 79 bopd

COMPLETED

J. G. McGEHEE

County Barton State Kansas
 Sec. 31 (Blk. 16) (Sur. 11W) Map No. 11W
 Operator Harms & Knight
 Well No. 1 Farm Janssen "B"
 Elev. 1881 Location NW SW SE

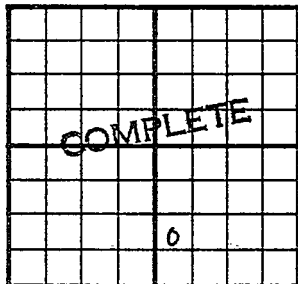

990 Ft. From S Line SE
330 Ft. From W Line Quarter
 Ist. Report MAR 25 1953
 Completion
 Remarks
 Spudding Date

Drlg. Data Oil well TD 3326
8" @ 298 DST 2964-94 open 1 hr.
Rec. 180' o & gcm 103# Lans. 3053
Arb. 3319 TD 3326 5" @ 3324
CO to 3326 500 A FU 150' oil $\frac{1}{2}$ hr.
S/ 8 boph 12 hr. P/ 50 bopd
comp. 79 bopd

J. G. McGEHEE