
KANSAS
FORM CP-5M PETROL

Barton

Section 31 Township 16 Range 11W

Well No. #1 Valenta

Company Black-Marshall

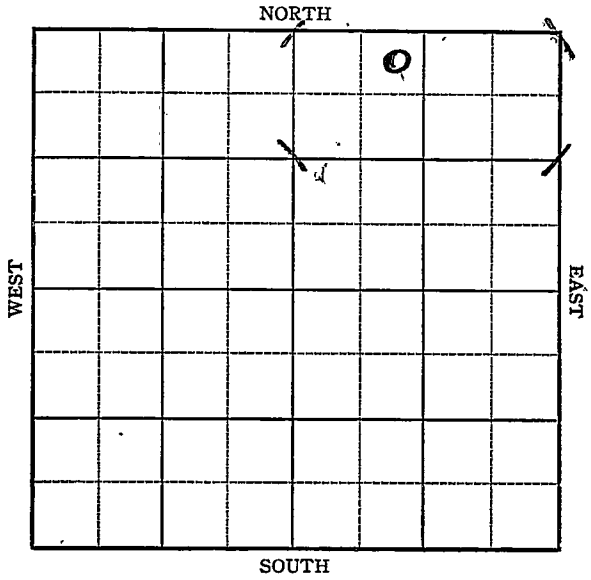

FORM 25 KANSAS
5M-9-43 CASS

Barton

Sec. 31 Twp. 16 R. 11W

Well No. #1 Valenta Farm

Black-Marshall Company

Kraft Prusa Pool


330 Ft. from N. Line

Ft. from S. Line

Ft. from E. Line

990 Ft. from W. Line

Elev. 1927

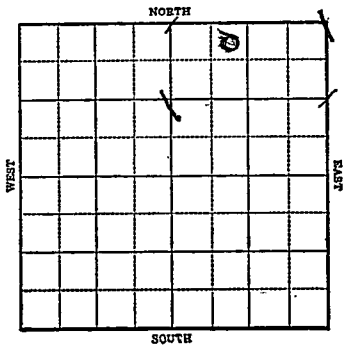

1944	REPORT
3/22	Cellar
3/29	Cable rig.
4/5	" "
4/12	Drlg. 400
4/19	12" @ 477 Anhy 755 10" @ 758 Drlg. 1210
4/26	8" @ 2054 Drlg. 2240
5/3	Drlg. 2500
5/10	8" @ 2464 Topeka 2630 TD 2861 SO. 5 M Gas run 6"
5/17	T.D. 2865 6" - 2850
5/ 24	Gas 2928-35 6" @ 2865 2960 NR
5/31	6 " @ 2965 Drlg. 2975

OVER

1944

6/7 Drlg. 3000 TD
Trying to shut off gas 2950-55

6/15 6" @ 3030
Pull 8"

6/21 6" @ 330
TD 3035

7/5 6" @ 3030
Topeka 2630
TD 3035
1000 acid.
5 M. Gas.

COMPLETED

Form 26 200BK 5-42 Petrol KANSAS Barton

Map No. 55 Sec. 31 Twp. 16 R. 11W


Well No. 1 Valenta

Black-Marshall Company

FIRST REPORT Contractor

NE NW NE

SECTION PLAT

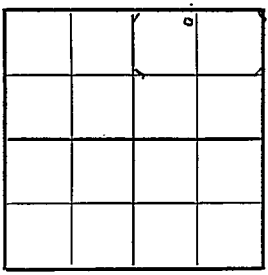

330 Ft. from N. Line

Ft. from S. Line

Ft. from E. Line

990 Ft. from W. Line

Kraft Prusa Pool

Location

Rig up

Drilling and Remarks:

Cellar

RECORD

Cased in., ft.

Sand

Gas

Oil

Total Depth

PRODUCTION

1st 24 hrs. Nat.

1st 24 hrs. after shot

Gas Cu. Ft.

Dry Hole

Abandoned

Date

MAR 22 1944 19

S. J. LEWIS Scout

FORM 26 200 BKS 1-44 PETROL

KANSAS

Pool Name Kraft Prusa

Map No. Sec. 31 Twp. 16 R. 11W

Well No. 1 Valenta

Black-Marshall Company

COMPLETED Contractor

NE NW NE

330 Ft. from N. Line


Ft. from S. Line

Ft. from E. Line

990 Ft. from W. Line

Barton County

SECTION PLAT

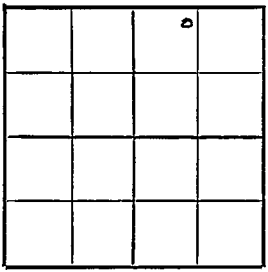

Location

Rig up

Drilling and Remarks:

Topeka 2630
6" @ 3030
1000 acid
5 M Gas

RECORD

Cased in., ft.

Sand

Gas

Oil

Total Depth 3035

PRODUCTION

1st 24 hrs. Nat.

1st 24 hrs. after shot

Gas Cu. Ft.

Dry Hole

Abandoned

Date

JUL 5 1944 19

S. J. LEWIS Scout