

Barton

FORM 51 5M 6-46 PETROL


KANSAS S

Section 31 Township 16 Range 11W

Well No. 4 Valenta

Company Black-Marshall

Kraft-Prusa NORTH

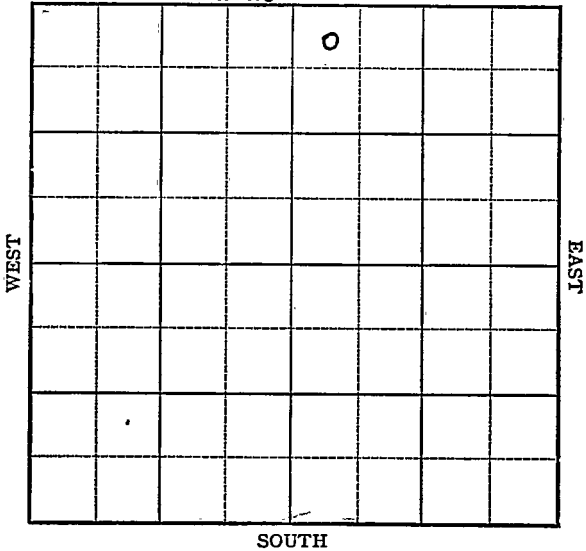

KANSAS

Barton County

Sec. 31 Twp. 16 R. 11W ☒ ☒

Well No. 4 Valenta Farm

Black-Marshall Company

Kraft-Prusa


NORTH

330 Ft. from N. Line

Ft. from S. Line

Ft. from E. Line

330 Ft. from W. Line

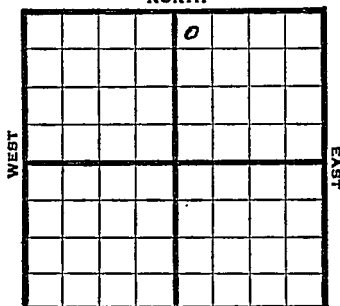

NW NE

1947 Elev. 1928: REPORT

5/7	Surface hole
5/13	8" @ 240' Drlg. 2780'
5/20	Lans 3011 Sand 3162-70 TD 3179' 5" @ 3163' RUST
5/27	TD 3181' SD
6/3	TD 3181' 12 shots 3134-38 500 acid Pump 30 bbls oil in 6 hrs.
6/111	Sand 3162' 5" @ 3163' Lans. 3011' Perf. 3134-38' 500 Acid Pump 150 Pot 42.0 Gr. TD 3181'

COMPLETED

Map No. 1555 Sec. 31 Twp. 16 R. 11W

Well No. 4 Valenta

Black-Marshall Company

FIRST REPORT Contractor

NW NE


SECTION PLAT

330 Ft. from N. Line

 Ft. from S. Line

 Ft. from E. Line

330 Ft. from W. Line

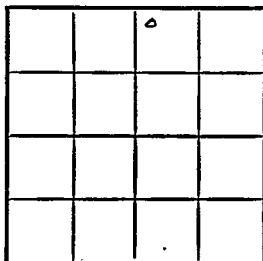

Barton County

Location

Rig up

Drilling and Remarks:

surface hole

RECORD

Cased in., ft.

Sand

Gas

Oil

Total Depth

PRODUCTION

1st 24 hrs. Nat.

1st 24 hrs. after shot

Gas Cu. Ft.

Dry Hole

Abandoned

Date

MAY 7 1947

S. J. LEWIS Scout

Map No. 55 Sec. 31 Twp. 16 R. 11W

Well No. 4 Valenta

Black-Marshall Company

COMPLETE

Contractor

NW NE

E. 1928
SECTION PLAT

330 Ft. from N. Line

 Ft. from S. Line

 Ft. from E. Line

330 Ft. from W. Line

		<i>a</i>	

Barton County

Location

Rig up

Drilling and Remarks:

Sand 3/62
5" @ 3/63
Lane 3011
Ref. 313438
500 acft
Pump 150 Ps
42 1/2 lb

RECORD

Cased in., ft.

Sand

Gas

Oil

Total Depth 3/87

PRODUCTION

1st 24 hrs. Nat.

1st 24 hrs. after shot

Gas Cu. Ft.

Dry Hole

Abandoned

Date

JUN 1 1 1947 19

S. J. LEWIS

Scout