

Barton

FORM 51

Section 31 Township 16 Range 11 ^{KANSAS}

Well No. #4 Valenta

Company Skelly Oil

NORTH

						0	

SOUTH

WEST

EAST

SEC.	TWP.	R.
31	16	11W ✓
WELL NO.		
4 Valenta		FARM
COMPANY		
Skelly Oil		
CONTRACTOR		

Kraft-Prusa Pool


_____ Ft. from N. Line

990 _____ Ft. from S. Line

990 _____ Ft. from E. Line

_____ Ft. from W. Line

NW SE NE

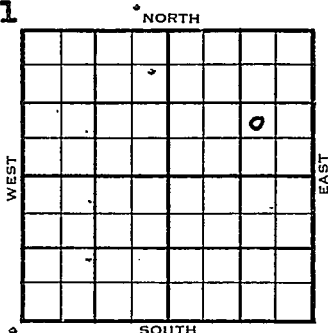

	ELEVATION	REPORT
1954		
1/6	Location	
1/13	Anhy 737'	
	8" @ 745'	
	Drlg. 2720'	
1/20	Heeb 2951', Tor 2963', Doug sha	
	2980', Doug sd 2995'	
	DST 2979-3050', 1 hr., 60' m, 470#	
	Br li 350', Lans 3065', Cong 3323',	
	Arb. 3343'	
	DST 3313-44, 1 hr., 6' m, 20#	
	RTD 3376'	
	5" @ 3353'	
1/27	CO 3376'	
	S/163 bw 7 hrs.,	
	PB 3337', 59/3324-34	
	Sd-o-frac,	
	PB 3041, 84/2998-3012, 14 gwph	
	+ scum oil 12 hrs.	
	Sd-frac	
2/3	S/143 BWFD sq 50/2970-78, 500A	
	S/26 BW 14 hrs. sq.	
2/10	CO 3335 47/3206-14 24/3078-3102	
	500 A	

OVER


1954
6/9

Spud 1-4-54 D & A TD 3376
Anhy 737 8" @ 745 eeb 2951'
Tor. 2963 Doug. sh. 2980'
Doug sd. 2995'
DST 2979-3050 open 1 hr rec 60' mud
470# Br. lime 3050' Lans 3065
Cong. 3323 Arb. 3343
DST 3313-44 open 1 hr rec 6' mud 20#
Qtz. 3372 TD 3376 5" @ 3353
CO to 3376 S/163 BW 7 hr. SP 3337
59/3324-34 sd-oil-frac. PB 3041
84/2998-3012 14 GWPH scum oil 12 hr.
sd-frac. S/143 BWPD 50/2970-78
500 A S/26 BW 14 hr. CO to 3335
47/3206-14 24/3078-3102 500 A
PB 2941 45/2895-2906 500 A
S/15 BW 9 hr. PB 2830' 45/2795-2806
500 A S/78 BW 11 hr. D & A

ABANDONED

J. G. McGEHEE

County Barton State Kansas
 Sec. 31 (Blk.) 16 (Sur.) 11W Map No.
 Operator Skelly Oil
 Well No. 4 Farm Valenta
 Elev. 1904 Location NW SE NE

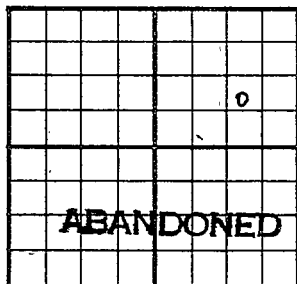

990 Ft. From S Line NE
990 Ft. From E Line Quarter

1st. Report

Completion JUN 9 1954

Remarks Kraft-Prusa Pool

Spudding Date 1-4-54

Drilg. Data D & A TD 3376

Anhy 737 8" @ 745 Heeb. 2951

Tor. 2963 Doug. sh. 2980 Doug. sd. 2995

DST 2979-3050 open 1 hr. Rec. 60' mud

470# Br. lime 3050 Lans. 3065

Cong. 3323 Arb. 3343 DST 3313-44

open 1 hr. Rec. 6' mud 20# Qtz. 3372

TD 3376 5" @ 3353 CO to 3376

S/ 163 bw 7 hr. SP 3337 59/ 3324-34

sd-oil-frac PB 3041 84/ 2998-3012

14 gwph scum oil 12 hr. sd-frac

S/ 143 bwpd 50/ 2970-78 500 A

S/ 26 bw 14 hr. CO to 3335 47/ 3206-14

24/ 3078-3102 500 A 500 A PB 2941

45/ 2895-2906 500 A S/ 15 bw 9 hr.

J. G. McGEHEE

Drlg. Data

PB 2830 45/ 2795-2806 500 A S/ 78 bw

41hr.

D & A

Scout Cards
Land Small Map
Land Wall Map
Tracings
France Map
Peace Map
Misc.

mm

JUN 15 1954

406-1111-1111