


DX 78-1

Section 33 Township 34 Range 3E

Well No. 2 Lawson

Company Gross Drlg.

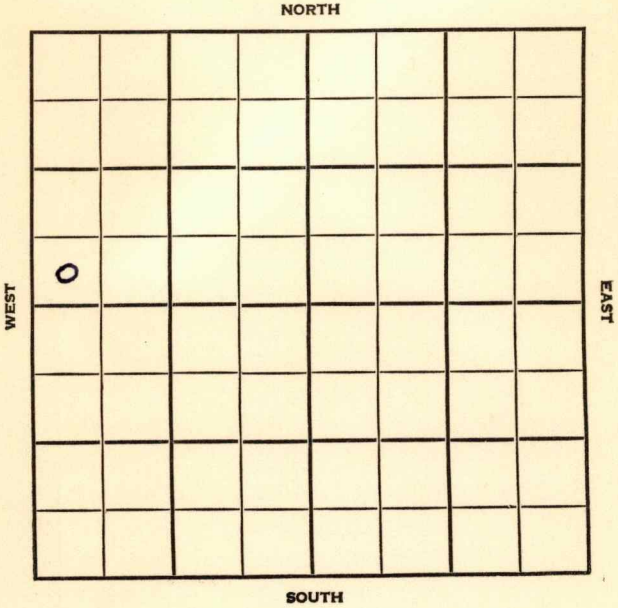

Cowley KANSAS


SEC.	TWP.	R.
33	34	3E

WELL NO. **2 Lawson** FARM

COMPANY **Gross Drlg.**

CONTRACTOR **Gross Drlg.
Gibson Pool**

_____ Ft. from N. Line
330 _____ Ft. from S. Line
 _____ Ft. from E. Line
330 _____ Ft. from W. Line

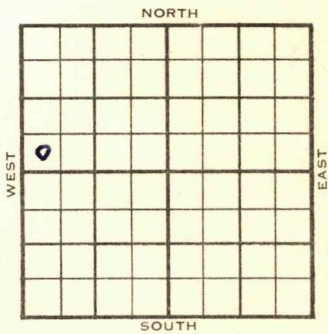

SW SW NW

	ELEVATION	REPORT
1954	1158	

6/23 Spud 6-19-54
 8" @ 100'
 Drlg. 525'

8/4 Spdg 6-19-54
 Oil well
 T D 3802
 8" @ 100
Layton 2669 Cleve 3006
 DST 3015-49 open 1 hr. Rec. 500' mud
 120' g & ocm 450' mud 480' sw
KC 2865 Oswego 3073 Miss. ch. 3404
Miss. lime 3444 Kh. 3674 Simp. 3721
Arb. 3795
 TD 3797
 5" @ 3787
 DD 3802
 Comp. F/ 305 bopd

COMPLETED

County Cowley State Kansas

Sec. 33 (Blk. Twp.) 34 (Sur. Rge.) 3E Map No.

Operator Gross Drlg.

Well No. 2 Farm Lawson

Elev. 1158 Location SW SW NW

330 Ft. From S Line NW

330 Ft. From W Line Quarter

Ist. Report

Completion AUG 4 1954

Remarks Gibson Pool

Gross Drlg. - Contr.

Spudding Date 6-19-54

Drlg. Data Oil well TD 3802

8" @ 100 Layton 2669 Cleve. 3006

DST 3015-49 open 1 hr. Rec. 500' mud

120' g & ocm 450' mud 480' sw

KC 2865 Oswego 3073 Miss. ch. 3404

Miss. lime 3444 Kh. 3674 Simp. 3721

Arb. 3795 TD 3797 5" @ 3787 DD 3802

Comp. F/ 305 bopd

J. G. McGEHEE