


Section 33 Township 34 Range 3E
Well No. #2 ^{Ross} Somers (J. Ross Somers)
Company Aladdin Petroleum

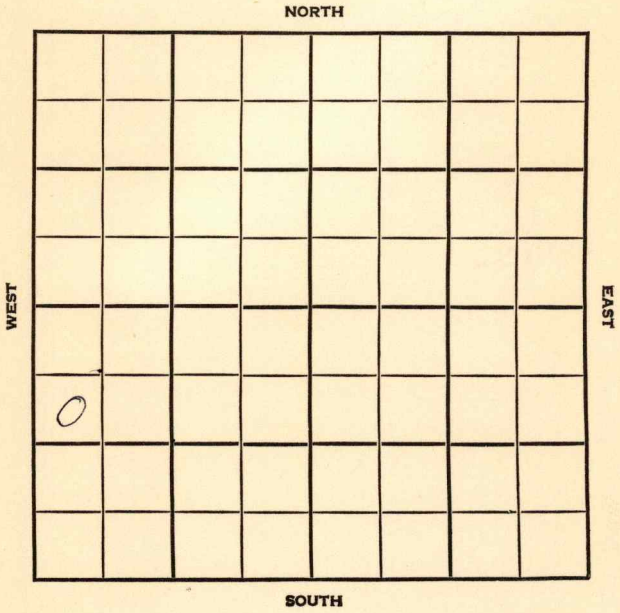

County Cowley Elev. _____
 Sec. 33 Twp. 34 Rge. 3E
 Company Aladdin Petroleum
 Farm Name Somers No. 2

TOPS	DEPTH	LOG	DATUM
Anh.			
TP.			
H.			
Tr.			
Dg.			
Bl.			
L.			
K.C.			
B.K.C.			
Ce.			
C.			
M.			
M.			
K.			
Mz.			
Me.			
V.			
S.			
S.			
A			
R.			
PE.			
G.			
T.D.			

Loc. in Sec. SW NW SW
 Geol. _____
 Contr. Crowe Drlg.
 Pool Gibson

FIRST REPORT
 0
 OCT 31 '56

Date Comm. MIRT

NOV 5 5 1956

R.C.

[Handwritten signature]

Co.
Lse.
No.
Sec.
T.
R.

County Cowley Elev. 1159
 Sec. 33 Twp. 34 Rge. 3E
 Company Aladdin Petroleum
 Farm Name Somers ROSS Somers No. 2

TOPS	DEPTH	LOG	DATUM	Loc. in Sec.
Anh.				SW NW SW
Tr.				
H.				
Tr.				
Dg.				
Bl.				
L.	2674			Geol.
K.C.	2879			Contr.
B.K.C.	3012			Crowe Drlg.
Ce.	Bar/12m 3390			Pool
C.				Gibson
M.	3414			
M.				
K.				
Mz.				
Mo.				
V.				
S.	3766			ABANDONED
S.				
A.	3800			
R.				
PE.				DEC 3 '56
G.				
TD.	3848			

Date Comm. MIRT NOV 7 '56 10-29-56 85/8 125
1125 # 2353 NOV 13 '56 # 3502 NOV 21 '56
core 3295-3410 FULL rec
core 3766-3807 # 3810 NOV 28 '56
5 1/2 3847 WOCT DEC 5 '56 12/3803
-07 Hole FULL wth 56d 28/
~~3768~~ 73 / No Frac \$ Ld + wts
DEC 12 '56 \$ 2 Boph + 17 Bwph 17
ms D & A