


DX 78-1 Cowley

KANSAS

Section 33 Township 34 Range 3E

Well No. #1 Arnett

Company Hill & Hill

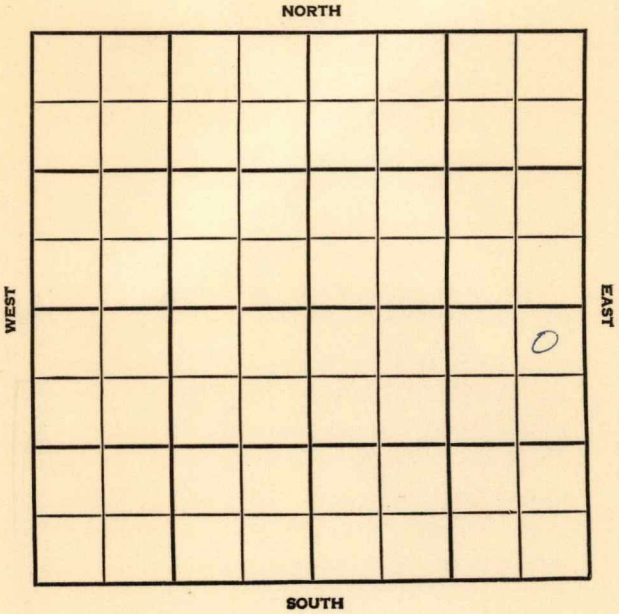

Cowley

KANSAS

SEC. 33

TWP. 34

R. 3E

WELL NO. #1 Arnett FARM

COMPANY Hill & Hill

CONTRACTOR Watson

Brandenberg


\_\_\_\_\_ FT. FROM N. LINE

\_\_\_\_\_ FT. FROM S. LINE

\_\_\_\_\_ FT. FROM E. LINE

\_\_\_\_\_ FT. FROM W. LINE

NE NE SE

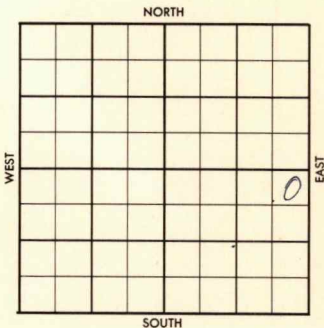

	ELEVATION	REPORT
1956	1151	

8-22 Comm. 8-17-56  
 8" @ 138 w/150  
 Drlg. 2375

9-5 Comm 8-17-56  
 ⚡ Tops:  
 Lay 2659, Osw 3050, Chat 3411,  
 Sd 3759, A 2840,  
 TD 3855  
 8" @ 138/150  
 D & A

ABANDONED

County Cowley Elev. \_\_\_\_\_  
 Sec. 33 Twp. 34 Rge. 3E  
 Company Hill & Hill  
 Farm Name Arnett No. 1

TOPS	DEPTH	LOG	DATUM	Loc. in Sec.
Anh.				NE NE SE
Tr.				
H.				
Tr.				
Dg.				
Bl.				
L.				Geol. _____
K.C.				Contr. _____
B.K.C.				<u>Watson</u>
Ce.				
C.				Pool _____
M.				<u>Brandenberg</u>
M.				
K.				
Mz.				
Me.				
V.				
S.				
S.				
A.				
R.				
PE.				
G.				
T.D.				

FIRST REPORT  
 AUG 22 56

Date Comm. 8-17-56  
8" @ 138/150 drlg. 2375

3301 P S 20A

29

3301 P S 20A

Co.  
Lse.  
No.  
Sec.  
T.  
R.

County Cowley Elev. 1157  
 Sec. 33 Twp. 34 Rge. 3E  
 Company Hill & Hill  
 Farm Name Arnett No. 1

TOPS	DEPTH	LOG	DATUM	Loc. in Sec.
Anh.				NE NE SE
Tp.				
H. <u>Lay</u>	<u>2659</u>			
Tr. <u>ASW</u>	<u>3050</u>			
Dg.				
Bl.				
L.				Geol.
K.C.				
B.K.C.				Contr.
Ce.				<u>Watson</u>
C.				
M. <u>chat</u>	<u>3411</u>			Pool
M.				<u>Brandenberg</u>
K.				
Mz.				
Ma.				
V.				
S. <u>sd</u>	<u>3759</u>			<div style="border: 1px dashed black; padding: 5px; display: inline-block;">                     ABANDONED                 </div>
S.	<u>3840</u>			
A.				
R.				
Pe.				0
G.				
T.D.	<u>3855</u>			<div style="border: 1px dashed black; padding: 5px; display: inline-block;">                         SEP 5 '56                     </div>

Date Comm. 8-17-56  
8" @ 138/150 drlg. 2375 AUG 29 '56  
Ø 3693 SEP 5 '56

D & A

SEP 1 1956

ON M