

O.W.W.O.

FORM 51 25M 3-49 PETROL

Cowley

KANSAS

Section 33 Township 34 Range 3 E

Well No. # 1 Sommers *(J. Ross Somers)*

Company ~~Burnstein & Hurd~~ Torbook Oil & Gas


NORTH

SW SW SW

Martin

WEST

EAST

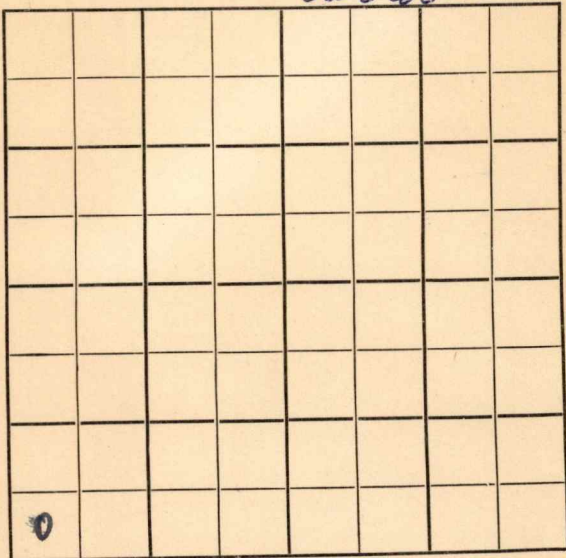

SOUTH

Cowley

KANSAS

Sec. 33 Twp. 34 R. 3EWell No. #1 Sommers FarmBurnstein & Hurd Company

Contractor


Ft. from N. Line

330 Ft. from S. Line

Ft. from E. Line

330 Ft. from W. Line

SW SW SW

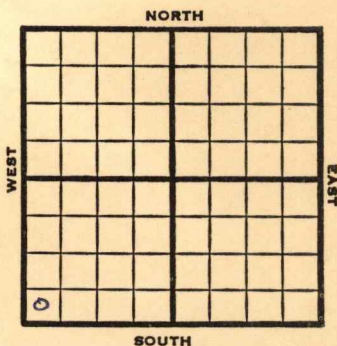

1952 Elev. 1166' REPORT

11/18 Spud 11-12-52
8" @ 113'
Drlg. 1791'

11/26 Spud 11-12-52
D&A

TD 3470'

8" @ 113

severy sd. 1458, Stal. 2269,
Layton 2692, KC 2894, Peru 3020,
Oswego 3065, Bart 3408, Miss
3458, Miss. lime 3466

TD 3470

D&A

ABANDONED

County	Cowley				State	Kansas
Sec.	33	(Blk.) (Twp.)	34	(Sur.) (Rge.)	3E	Map No.

Sec. **33** (Blk. Twp.) **34** (Sur. Rge.) **3E** Map No.

Operator **Burnstein & Hurd**

Well No. **1** Farm **Sommers**

Elev.	Location	SW	SW	SW
-------	----------	----	----	----

330 Ft. From S Line SW

330 Ft. From W Line Quarter

1st. Report NOV 19 1952

Completion


Remarks

Spudding Date 11-12-52

Drlg. Data

8" @ 113 drlg. 1791

J. G. McGEHEE

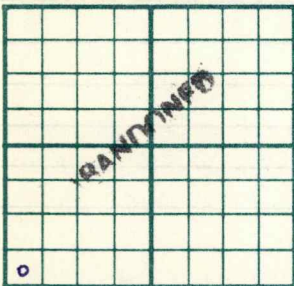County Cowley State KansasSec. 33 (Blk.
Twp.) 34 (Sur.
Rge.) 3E Map No.Operator Burnstein & HurdWell No. 1 Farm SomnersElev. 1166 Location SW SW SW330 Ft. From S Line SW330 Ft. From W Line Quarter1st. ReportCompletion NOV 26 1952RemarksSpudding Date 11-12-52Drlg. Data D & A TD 34708" @ 113 severy sd. 1458 Stal. 2269Layton 2692 KC 2894 Peru 3020Oswego 3065 Bart. 3408 Miss. 3458Miss. lime 3466 TD 3470D & A

Top ~~XXXX~~ Feet ~~XXXX~~

Co. ~~XXXX~~ Feet ~~XXXX~~

O.W.W.O.

S-513-B

County Cowley Elev. 1166 DF
Sec. 33 Twp. 34 Rge. 3E
Company Torbrook Oil & Gas & Martin
Farm Name Somers No. 1

TOPS	DEPTH	LOG	DATUM
Anh.			
Tp.			
H.			
Tr.			
xx Stal	2269		
xx Lay	2692		
L.			
K.C.	2891		
xx Peru	3020		
xx Osw	3065		
xx Stvl Sd	3108		
M.	3458		
M.L	3466		
K.			
Mz.			
Mq.			
V.			
S.			
S.			
A.			
R.			
Pf.			
G.			
OTD	3470		
T.D.			

Loc. in Sec. SW SW SW
(O.W.W.O.)

Geol. O.W.W.O.
Contr.

Pool

JUN 2 1930
FIRST REPORT

Date Comm. OLD INFO? Tops. D & A.
NEW INFO: Wash down.

Co.
Lse.
No.
Sec.
T.
R.

Twp. X Pool XCo. X Facet X

O.W.W.O.

S-513-B

County Cowley Elev. 1166 DF
 Sec. 33 Twp. 34 Rge. 3E
 Company Torbrook Oil & Gas & Martin
 Farm Name Somers No. 1

TOPS	DEPTH	LOG	DATUM
Anh.			
Tp.			
H.			
Tr.			
Stal	2269		
lay	2692		
L.			
K.C.	2891		
Perm	3020		
CSW	3065		
Sd	3108		
M.	3158		
M.L.	3466		
K.			
Mz.			
Mq.			
V.			
S.			
S.			
A.			
R.			
Pf.			
G.			
DTD	3470		
T.D.			

Loc. in Sec.

SW SW SW

(O.W.W.O.)

Geol. O.W.W.O.

Contr.

Pool Gibson sq.

COMPLETE

SEP 17 '58

Date Comm.

OLD INFO? Tops. D & A.NEW INFO: Wash down. JUN 11 '58 CO 34703" 3470 WOC JUN 18 '58 JUN 25 '58 24/3408-13 \$ SW PB JUL 2 '58 onpump JUL 9 '58 JUL 16 '58 JUL 23 '58 JUL 30 '58AUG 6 '58 AUG 13 '58 AUG 20 '58 AUG 27 '58SEP 3 '58 SEP 10 '58 SEP 17 '58 PB 3450P 11 B0 + 600 BW pd