


Section 33 Township 34 Range 3E

Well No. 1 ~~Ross-Sommers~~

Company Aladdin Petr.

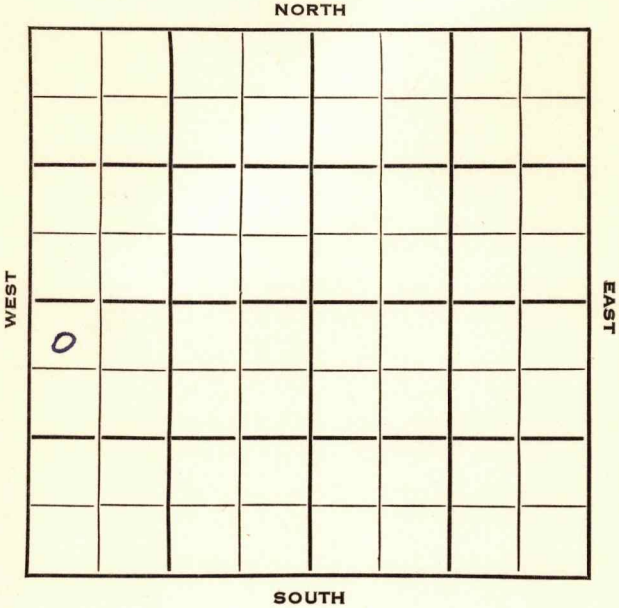

Cowley KANSAS


SEC.	TWP.	R.
33	34	3E

WELL NO. _____
 COMPANY 1 Ross-Sommers FARM

CONTRACTOR Aladdin Petr.

Gibson Pool

330 _____ Ft. from N. Line
 _____ Ft. from S. Line
 _____ Ft. from E. Line
 330 _____ Ft. from W. Line

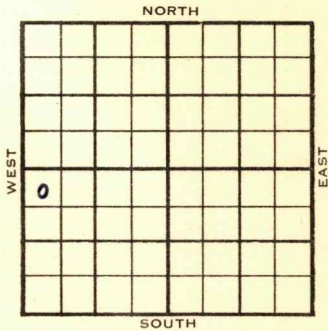

NW NW SW

1954	ELEVATION	REPORT
	1156'	

4/7
6/30

C&P
 Spud 4-16-54 Oil well TD 3873
 8" @ 131 Miss 3422 Simp. sh. 3735
 Simp sd. 3763 Arb. 3800
 TD 3873 5" @ 3800 CO to 3873
 F/55 BOPH F/55 BO 1/2 hr.
 omp. 2250 BOPD

COMPLETED

County Cowley State Kansas

Sec. 33 (Blk. Twp.) 34 (Sur. Rge.) 3E Map No.

Operator Aladdin Pet.

Well No. 1 Farm Ross - Sommers

Elev. 1156 Location NW NW SW

330 Ft. From N Line SW

330 Ft. From W Line Quarter

1st. Report

Completion JUN 30 1954

Remarks Gibson Pool

Spudding Date 4-16-54

Drlg. Data Oil well TD 3873

8" @ 131 Miss. 3422 Simp. sh. 3735

Simp. sd. 3763 Arb. 3800 TD 3873

5" @ 3800 CO to 3873 F/ 55 boph

F/ 55 bo 1/2 hr. Comp. 2250 bopd

COMPLETE