


Lowley

Map No. *15* Sec. *35* Twp. *34* R. *3E*

Well No. *1-Debard* Farm
Derby Oil Company

NORTH

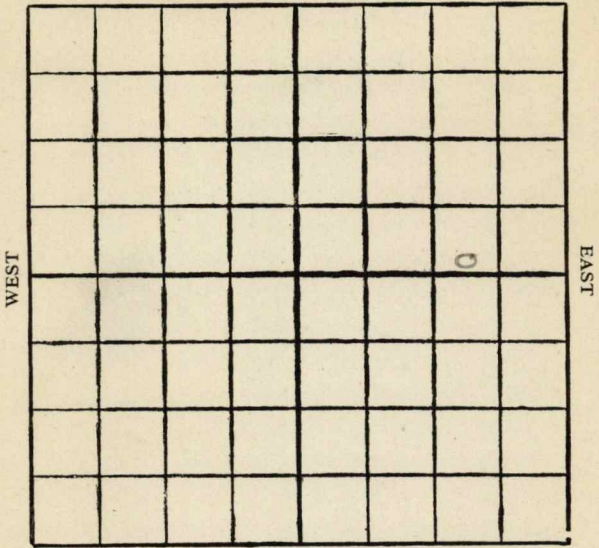

SOUTH

Location

Rig Up

Drilling Remarks

Drilling Remarks

.....

.....

RECORD

PRODUCTION

Cased in. ft.

Sand

Gas

Oil

Total Depth

1st 24 hrs. Nat.

1st 24 hrs. after shot

Gas cu. ft.

Dry Hole

Abandoned

Cowley

Map No. *15* Sec. *35* Twp. *34* R. *3E*


Well No. *1-Sebard* Farm
Derby Oil Company

..... Ft. from N. Line

300 Ft. from S. Line

990 Ft. from E. Line

..... Ft. from W. Line

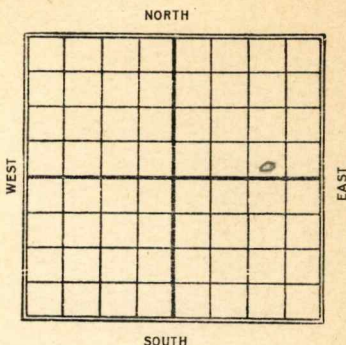

1926

Date REPORT

<i>12/15</i>	<i>Rig</i>
<i>12/21</i>	<i>Spud</i>
<i>12/29</i>	<i>Spud 100</i>
<i>1927</i>	
<i>1/5</i>	<i>Drilling - 500</i>
<i>1/12</i>	<i>" 1290</i>
<i>1/19</i>	<i>" 1575</i>
<i>1/26</i>	<i>" 1845</i>
<i>2/2</i>	<i>topsand 1940 show gas</i> <i>DS. 1950 water 1944</i> <i>T.D. 1954 7R. 6"</i>
<i>2/9</i>	<i>show oil 1972 - 76</i> <i>Drilling 1987</i>
<i>2/16</i>	<i>shut down</i>
<i>2/23</i>	<i>_____</i>
<i>3/2</i>	<i>_____</i>
<i>3/9</i>	<i>_____</i>
<i>3/16</i>	<i>_____</i>
<i>3/23</i>	<i>T.D. 2063 - S.D.</i>
<i>3/30</i>	<i>no report</i>
<i>4/6</i>	<i>T.D. 2063</i> <i>4 x 9</i>

County *Cowley*
 Map No. *ANSAS* Sec. *35* Twp. *34* R. *3E*

Well No. *1 Herdard*

Herby Oil Company
 Contractor

SECTION PLAT

			<i>0</i>

----- Ft. from N. Line

200 Ft. from S. Line

990 Ft. from E. Line

----- Ft. from W. Line

FIRST REPORTS

Location -----

Rig up -----

Drilling and Remarks:

Rig.
2000' Test.

RECORD

Cased ----- in., ----- ft.

Sand -----

Gas -----

Oil -----

Total Depth -----

PRODUCTION

1st 24 hrs. Nat. -----

1st 24 hrs. after shot -----

Gas ----- Cu. Ft.

Dry Hole -----

Abandoned -----

Date

DEC 15 1926

S. J. LEWIS

Map No. **KANSAS** Sec. *35* Twp. *34* R. *3E*

Well No. *1 The Bard*

Teety Oil Company

Contractor

SECTION PLAT

----- Ft. from N. Line

300 Ft. from S. Line

990 Ft. from E. Line

----- Ft. from W. Line

			<i>0</i>

ABANDONED

Location -----

Rig up -----

Drilling and Remarks:

T 2063

J & A.

RECORD

Cased ----- in., ----- ft.

Sand -----

Gas -----

Oil -----

Total Depth -----

PRODUCTION

1st 24 hrs. Nat. -----

1st 24 hrs. after shot -----

Gas ----- Cu. Ft.

Dry Hole -----

Abandoned -----

Date

APR 6 1927

S. J. LEWIS

192

Scout

Cowley

MAP No. **K1** **KANSAS** SEC. *35* TWP. *31S* R. *3E*

WELL No. *1 Deford*

Plenty COMPANY

CONTRACTOR

ABANDONED

SECTION PLAT

			<i>o</i>

_____ FT. FROM N. LINE

_____ FT. FROM S. LINE

_____ FT. FROM E. LINE

_____ FT. FROM W. LINE

LOCATION _____

RIG UP _____

DRILLING AND REMARKS:

ash

RECORD

CASED _____ IN., _____ FT.

SAND _____

GAS _____

OIL _____

TOTAL DEPTH *5006*

PRODUCTION

1ST 24 HRS. NAT. _____

1ST 24 HRS. AFTER SHOT _____

GAS _____ Cu. Ft.

DRY HOLE

ABANDONED

DATE

4/5

192

7

SCOUT