

Map No. \_\_\_\_\_ Sec. 1 Twp. 23 4 R. 4  
Well No. 1 Walton Farm  
Nat Foster Company

WEST

EAST

SOUTH

Rig Up-----

Drilling Remarks:

## PRODUCTION

1st 24 hrs. Nat. -----


1st 24 hrs. after shot-----

Gas -----cu. ft.

Dry Hole\_\_\_\_\_

Abandoned-----

200 Ft. from W. Line

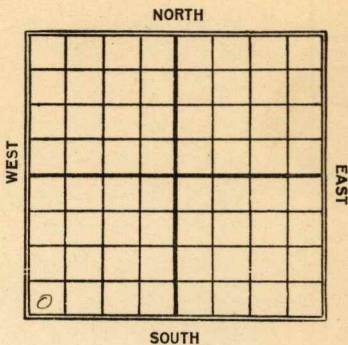

| Date         | REPORT        |
|--------------|---------------|
| 7/27<br>1923 | Dlg 810'      |
| 1/26         | D. & G. 3541' |

*Cowley*

MAP No. K2 **KANSAS** SEC. 1 TWP. 34S R. 4E

WELL No. 1 *Walton*  
*Not Drilled* COMPANY \_\_\_\_\_

CONTRACTOR \_\_\_\_\_

**ABANDONED**

**SECTION PLAT**

|  |  |  |  |
|--|--|--|--|
|  |  |  |  |
|  |  |  |  |
|  |  |  |  |
|  |  |  |  |

\_\_\_\_\_ FT. FROM N. LINE

\_\_\_\_\_ FT. FROM S. LINE

\_\_\_\_\_ FT. FROM E. LINE

\_\_\_\_\_ FT. FROM W. LINE

LOCATION \_\_\_\_\_

RIG UP \_\_\_\_\_

DRILLING AND REMARKS:

*OK*

**RECORD**

CASED \_\_\_\_\_ IN. \_\_\_\_\_ FT.

SAND \_\_\_\_\_

GAS \_\_\_\_\_

OIL \_\_\_\_\_

TOTAL DEPTH 3541

**PRODUCTION**

1ST 24 HRS. NAT. \_\_\_\_\_

1ST 24 HRS. AFTER SHOT \_\_\_\_\_

GAS \_\_\_\_\_ CU. FT.

DRY HOLE ☒

ABANDONED ☒

DATE

1/26 1923

SCOUT

Map No. KANSAS 21 Sec. 1 Twp. 34 R. 4Well No. 1 WaltonMax Foster Company

Contractor

**ABANDONED SECTION PLAT**1120 Ft. from N. Line

Ft. from S. Line

200 Ft. from E. Line

Ft. from W. Line

|  |  |  |  |
|--|--|--|--|
|  |  |  |  |
|  |  |  |  |
|  |  |  |  |
|  |  |  |  |

Location

Rig up

Drilling and Remarks:

Tap line 3 1/6'**RECORD**

Cased in., ft.

Sand

Gas

Oil

Total Depth

**PRODUCTION**

1st 24 hrs. Nat.

1st 24 hrs. after shot

Gas Cu. Ft.

Dry Hole

Abandoned 3541

Date

JAN 26 1923

M. A. BENEAR

191

Scout

Map No. *KV* Sec. *1* Twp. *34* R. *4*Well No. *1 Walton*  
*Nat Foster* Company

Contractor

## FIRST REPORT

Ft. from N. Line

*200* Ft. from S. Line

Ft. from E. Line

*200'* Ft. from W. Line

## SECTION PLAT

|          |  |  |  |
|----------|--|--|--|
|          |  |  |  |
|          |  |  |  |
|          |  |  |  |
| <i>0</i> |  |  |  |

Location

Rig up

Drilling and Remarks:

*20. 810'*

## RECORD

Cased in., ft.

Sand

Gas

Oil

Total Depth

## PRODUCTION

1st 24 hrs. Nat.

1st 24 hrs. after shot

Gas Cu. Ft.

Dry Hole

Abandoned

Date

JUL 27 1922

191

M. A. BENEAR

Scout