



STATE CORPORATION COMMISSION OF KANSAS  
OIL & GAS CONSERVATION DIVISION  
WELL COMPLETION OR RECOMPLETION FORM  
ACO-1 WELL HISTORY  
DESCRIPTION OF WELL AND LEASE

Operator: License # 6678  
Name John E. Galemore  
Address PO Box B  
City/State/Zip Chanute, KS 66720

Purchaser Fairway Crude, Inc.

Operator Contact Person John E. Galemore  
Phone 316-431-6340

Contractor: License # 5956  
Name Gary Jackson Drilling

Wellsite Geologist  
Phone

Designate Type of Completion  
 New Well  Re-Entry  Workover  
 Oil  SWD  Temp Abd  
 Gas  Inj  Delayed Comp.  
 Dry  Other (Core, Water Supply etc.)

If OWO: old well info as follows:  
Operator  
Well Name  
Comp. Date Old Total Depth

WELL HISTORY

Drilling Method:  
 Mud Rotary  Air Rotary  Cable

6/23/86 6/29/86 7/4/86  
Spud Date Date Reached TD Completion Date

1141  
Total Depth PBTD

Amount of Surface Pipe Set and Cemented at 28 feet  
Multiple Stage Cementing Collar Used? Yes No  
If yes, show depth set feet  
If alternate 2 completion, cement circulated from feet depth to w/SX cmt  
Cement Company Name Consol Data  
Invoice #

API NO. 15-205-24, 412  
County Wilson  
NE/4 Sec. 1 Twp. 28 Rge. 15 East

4750 Ft North from Southeast Corner of Section  
1880 Ft West from Southeast Corner of Section  
(Note: Locate well in section plat below)


Lease Name Brazil #1 Well # 29

Field Name

Producing Formation Bartlesville

Elevation: Ground X KB

Section Plat

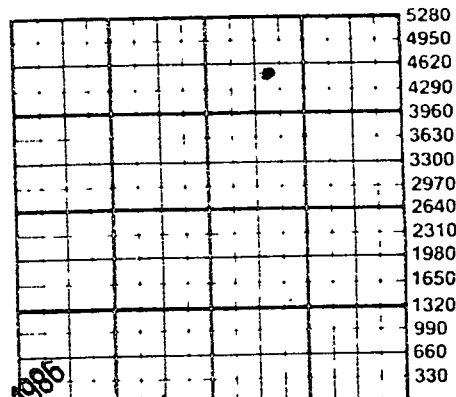

JUL 20 1986  
WATER SUPPLY INFORMATION

Disposition of Produced Water: Disposal  
Docket # Repressuring

Questions on this portion of the ACO-1 call:

Water Resources Board (913) 296-3717

Source of Water:  
Division of Water Resources Permit #

Groundwater Ft North from Southeast Corner (Well)  
Ft West from Southeast Corner of Sec Twp Rge East West

Surface Water Ft North from Southeast Corner (Stream, pond etc.)  
Ft West from Southeast Corner Sec Twp Rge East West

Other (explain)  
(purchased from city, R.W.D. #)

INSTRUCTIONS: This form shall be completed in duplicate and filed with the Kansas Corporation Commission, 200 Colorado Derby Building, Wichita, Kansas 67202, within 90 days after completion or recompletion of any well. Rule 82-3-130 and 82-3-107 apply.  
Information on side two of this form will be held confidential for a period of 12 months if requested in writing and submitted with the form. See rule 82-3-107 for confidentiality in excess of 12 months.  
One copy of all wireline logs and drillers time log shall be attached with this form. Submit CP-4 form with all plugged wells. Submit CP-111 form with all temporarily abandoned wells.

SIDE TWO

Operator Name John E Galemore Lease Name Brazil #1 Well # 29

Sec. 1 Twp. 28 Rge. 15 East West County Wilson

BEST COPY AVAILABLE

WELL LOG

INSTRUCTIONS: Show important tops and base of formations penetrated. Detail all cores. Report all drill stem tests giving interval tested, time tool open and closed, flowing and shut-in pressures, whether shut-in pressure reached static level, hydrostatic pressures, bottom hole temperature, fluid recovery, and flow rates if gas to surface during test. Attach extra sheet if more space is needed. Attach copy of log.

Drill Stem Tests Taken [ ] Yes [X] No
Samples Sent to Geological Survey [ ] Yes [X] No
Cores Taken [X] Yes [ ] No

Formation Description [ ] Log [X] Sample

Table with columns: Name, Top, Bottom, Oil, Gas, Water, Gas-Oil Ratio, Gravity. Includes 'Estimated Production Per 24 Hours' with values 5 Bbls and MCF.

METHOD OF COMPLETION

Production Interval

Disposition of gas: [X] Vented [ ] Sold [ ] Used on Lease [ ] Open Hole [X] Perforation [ ] Other (Specify) 1082-1090
[ ] Dually Completed [ ] Commingled

CASING RECORD, PERFORATION RECORD, TUBING RECORD, Date of First Production, Producing Method. Includes fields for Purpose of String, Size Hole, Size Casing, Weight, Setting Depth, Type of Cement, #Sacks Used, Type and Percent Additives, Shots Per Foot, Specify Footage of Each Interval Perforated, Acid, Fracture, Shot, Cement Squeeze Record, Liner Run, Date of First Production, Producing Method.