

Butler


KANSAS

Form 51-5M 5-37 Petrol

Section 34 Township 25 Range 5-E

Well No. 1 Smith

Company Rex & Morris

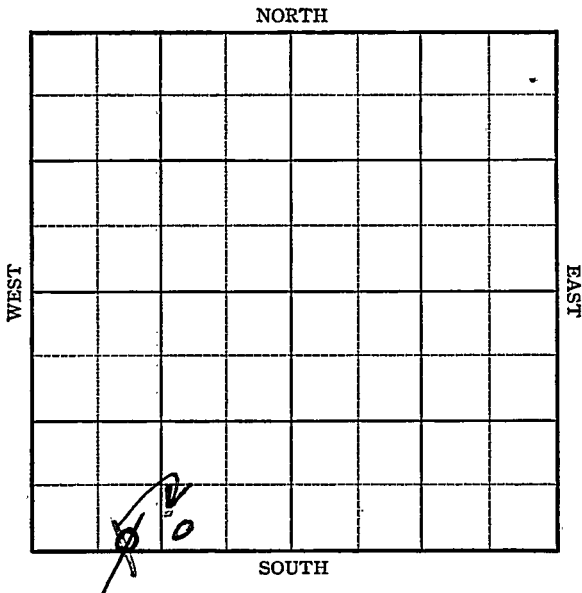



1937

11/23 5" @ 2568' . .

Wileox 2600' .

T.D. 2602' .

2000 acid.

No shows.

~~ABANDONED~~

ABANDONED

Butler KANSAS

Map No. 14 Sec. 34 Twp. 25 R. 5EWell No. 1 SmithRex & Morris Company

Contractor

**FIRST REAM**

## SECTION PLAT

SE SW SW

\_\_\_\_ Ft. from N. Line

50 Ft. from S. Line

\_\_\_\_ Ft. from E. Line

990 Ft. from W. Line


Location \_\_\_\_\_

Rig up \_\_\_\_\_

Drilling and Remarks:

15" - 90

Dlg -875

## RECORD

Cased \_\_\_\_\_ in., \_\_\_\_\_ ft.

Sand \_\_\_\_\_

Gas \_\_\_\_\_

Oil \_\_\_\_\_

Total Depth \_\_\_\_\_

## PRODUCTION

1st 24 hrs. Nat. \_\_\_\_\_

1st 24 hrs. after shot \_\_\_\_\_

Gas \_\_\_\_\_ Cu. Ft.

Dry Hole \_\_\_\_\_

Abandoned \_\_\_\_\_

Date

OCT - 6 1937

E. D. Hatfield

19

Scout

*Butler* KANSAS

Map No. 14 Sec. 34 Twp. 25 R. 5<sup>E</sup>

Well No. 1-Smith  
*Rex & Morris* Company

**CORRECTION**

Contractor

**SECTION PLAT**


*08*

\_\_\_\_\_ Ft. from N. Line

100 Ft. from S. Line

1215 Ft. from E. Line

\_\_\_\_\_ Ft. from W. Line

Location \_\_\_\_\_

Rig up \_\_\_\_\_

Drilling and Remarks:

*first reported as  
 50' From 50 Line &  
 990 ✓ w Line  
 Change as above*

**RECORD**

Cased \_\_\_\_\_ in., \_\_\_\_\_ ft.

Sand \_\_\_\_\_

Gas \_\_\_\_\_

Oil \_\_\_\_\_

Total Depth \_\_\_\_\_

**PRODUCTION**

1st 24 hrs. Nat. \_\_\_\_\_

1st 24 hrs. after shot \_\_\_\_\_

Gas \_\_\_\_\_ Cu. Ft.

Dry Hole \_\_\_\_\_

Abandoned \_\_\_\_\_

Date

NOV 23 1937 19

*W. D. Hatfield* Scout

