

Summer

Form 51-5M-2-29-34703

Map No. **KANSAS** Sec. 17

Twp. 35 R. 2^E

Well No. 1- Rosecrans

Farm
Company

NORTH

WEST

EAST

SOUTH

15

0

Location

Drilling Remarks

Rig Up

Drilling Remarks

RECORD

Cased in. ft.

Sand

Gas

Oil

Total Depth

PRODUCTION

1st 24 hrs. Nat.

1st 24 hrs. after shot

Gas cu. ft.

Dry Hole

Abandoned

Map No. **KANSAS** Sec. 17 Twp. 35 R. 2E

Well No. 1-Rosecrans Farm
Southland Royalty etal Company
NORTH


_____ Ft. from N. Line

330 Ft. from S. Line

_____ Ft. from E. Line

990 Ft. from W. Line

1932

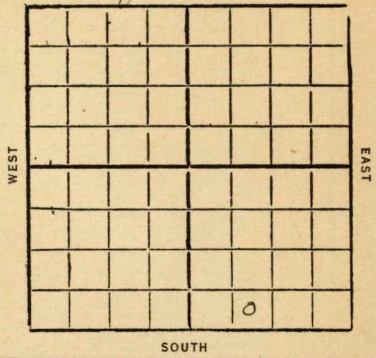

Date	REPORT
7/13	Dreg 1500'
7/20	" 3330'
7/27	Top Chat 3246
	Base line 3330
	Viola 3393
	Cem 8"-3383
	TD 3395' Rust
8/3	TD 3395 Bailing
8/10	Cem 8"-3381
	show oil 3411
	200' water 3416-22
	Top Silic line 3507
	HFW 3520
	TD 3522
	P.B. to chat
8/17	
8/24	Top Chat 3246
	" Viola 3393
	" Siliceous 3507
	HFW 3520
	TD 3522
	Abandoned

Summer

E

Map No. **KANSAS** Sec. 17 Twp. 35 R. 2

Well No. 1 Rosecrans

Southland Royalty Co. et al Company

Contractor

FIRST REPORTS

SECTION PLAT

Ft. from N. Line

330 Ft. from S. Line

Ft. from E. Line

990 Ft. from W. Line

Location

Rig up

Drilling and Remarks:

RECORD

Cased in, ft.

Sand

Gas

Oil

Total Depth

PRODUCTION

1st 24 hrs. Nat.

1st 24 hrs. after shot

Gas Cu. Ft.

Dry Hole

Abandoned

Date

JUL 13 1932 CHAS. L. SHERWOOD

Scout

Summer

2 KANSAS

Map No. Sec. 17 Twp. 35 R. 2 E

Well No. 1 Rosecrans

Southland Royalty Co. Company

Contractor

COMPLETED

SECTION PLAT

Ft. from N. Line

330 Ft. from S. Line

Ft. from E. Line

990 Ft. from W. Line

ABANDONED

Location

Rig up

Drilling and Remarks:

Top Chat 3746

" Viola 3393

" Siliceous 3507

HFW 3520

RECORD

Cased in., ft.

Sand

Gas

Oil

Total Depth 3522

PRODUCTION

1st 24 hrs. Nat.

1st 24 hrs. after shot

Gas Cu. Ft.

Dry Hole ✓

Abandoned ✓

Date

AUG 24 1932

192

CHAS. L. SHERWOOD

Scout