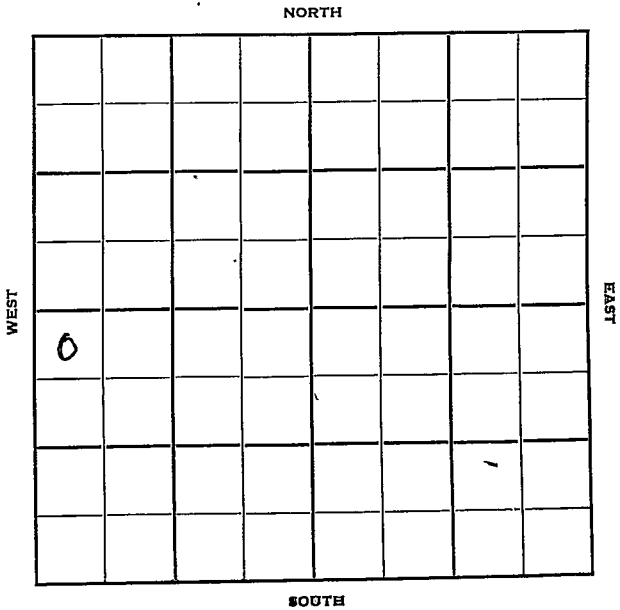


Section 34 Township 25 Range 5EWell No. #17 S. H. HillCompany Skelly Oil

Butler

KANSAS

Sec. 34 Twp. 25 R. 5 E

Well No. # 17 S. H. Hill Farm

Skelly Oil Company

Contractor

El Dorado Pool


330 Ft. from N. Line

Ft. from S. Line

Ft. from E. Line

330 Ft. from W. Line

NW NW SW

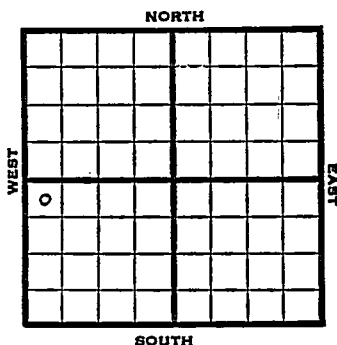

1951

Elev. 1365' REPORT

10/3

Location

11/28

Spud 10-15-51
Oil Well TD 2435
16" @ 68 10" @ 965
Lans. 1653
8" @ 1727 KC 1939
Arb. 2387-2425 $\frac{1}{2}$ boph
7" @ 2425
CO to 2435
1000 A P/15 bo 12 hrs. 2000 A
Comp. 15 bopd 123 bw

COMPLETED

County Butler State Kansas
 Sec. 34 (Blk. Twp.) 25 (Sur. Rge.) 5E Map No.
 Operator Skelly Oil
 Well No. 17 Farm S. H. Hill
 Elev. _____ Location NW NW SW

FIRST REPORT									
0									

330 Ft. From N Line SW
330 Ft. From W Line Quarter
 1st. Report OCT 3 1951
 Completion _____
 Remarks _____
 Spudding Date _____

Drilg. Data Eldorado Pool
 Location _____

