


Section 3 Township 35 Range 3E
Well No. 2 Brandenburg
Company Aylward & Ed Morris

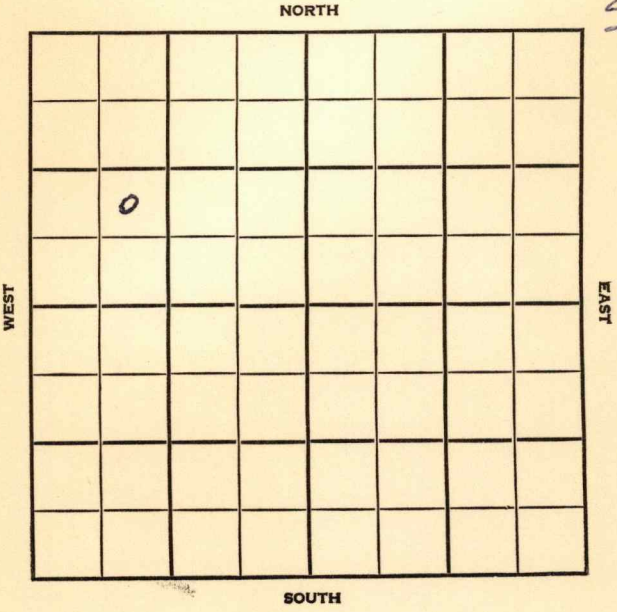

Cowley

KANSAS

SEC.	TWP.	R.
3	35	3E


WELL NO. #2 Brandenburg. FARM

COMPANY Aylward & Ed Morris

CONTRACTOR Aylward.

Brandenburg Pool

_____ Ft. from N. Line
 990 _____ Ft. from S. Line
 _____ Ft. from E. Line
 990 _____ Ft. from W. Line

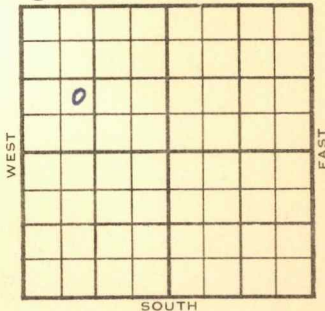

NE SW NW

1955	ELEVATION	REPORT
------	-----------	--------

4/20 Spud 4-16-55
 8" @ 95'
 Drlg. 784'

