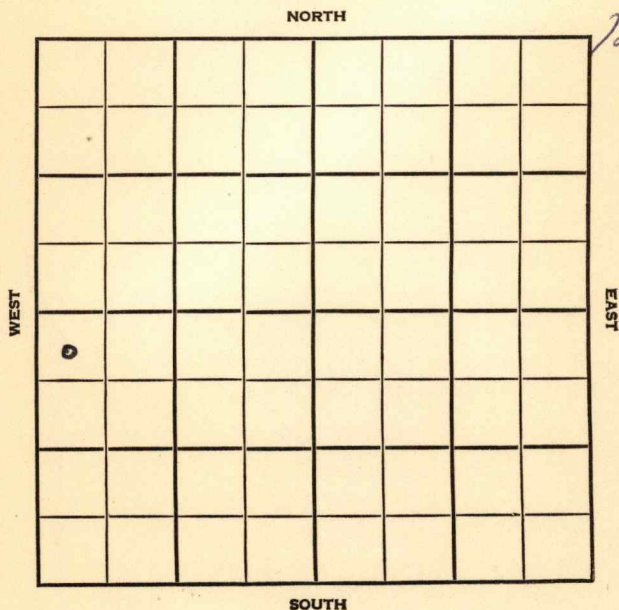


Section 4 Township 35 Range 3EWell No. 1 SomersCompany Art Holliday

4

35

3E

WELL NO.

#1 Somers

FARM

COMPANY

Art Holiday

CONTRACTOR

Smitherman

Wildcat

330

Ft. from N. Line

Ft. from S. Line

Ft. from E. Line

330

Ft. from W. Line

NORTH

WEST

SOUTH

EAST

NW NW SW

1955

ELEVATION

REPORT

1177'

2/16

Location

3/30

Spud 3-12-55 D & A TD 3890

8" @145

DST 1494-1521 open 1/2 hr rec 20' mud

Severy 1508 Stal. 2273 Layton 2698

DST 2704-14 open 1 hr rec 1250' SW

985# KC 2911 Cleve 3056

Oswego 3117' Bart. 3425 Miss 3466

Simp. 3781' Arb. 3881'

TD 3890' D & A

ABANDONED

County **Cowley** State **Kansas**
 Sec. **4** (Blk.) **35** (Sur.) **3E** Map No.
 (Twp.)
 Operator **Art Holliday**
 Well No. **1** Farm **Somers**
 Elev. Location **NW NW SW**

0							

330 Ft. From **N** Line **SW**
330 Ft. From **W** Line Quarter
 1st. Report **FEB 16 1955**

Completion

Remarks

Smitherman - Contr.

Spudding Date

Drlg. Data

Wildcat

Location

FABEN GILSTRAP

Well No. 1 Farm Somers

0

ABANDONED

330 Ft. From W Line Quarter

1st. Report

Completion MAR 30 1955

Remarks	Wildcat
---------	---------

Smitherman - Contr.

Spudding Date 3-12-55

Drlg. Data D & A TD 3890

8" @ 145 DST 1494-1521 open $\frac{1}{2}$ hr.

Rec. 20' mud Severy 1508 Stal. 2273

Layton 2698 DST 2704-14 open 1 hr.

Rec. 1250' SW 985# KC 2911

Cleve. 3056 Oswego 3117 Bart. 3425

Miss. 3466 Simp. 3781 Arb. 3881

TD 3890

D & A

FABEN GILSTRAP