


Section 2 Township 35 Range 3E

Well No. #1 Marshall

Company Aladdin Pet.

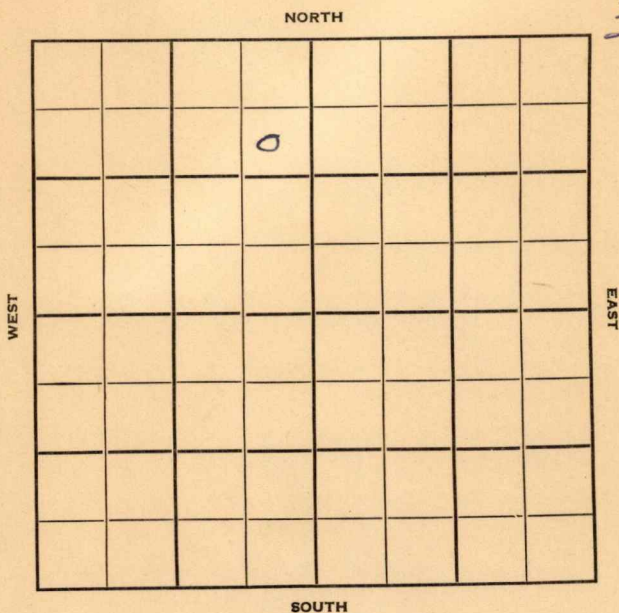

Cowley KANSAS

Sec. 2 Twp. 35 R. 3 E

Well No. # 1 Marshall Farm

Aladdin Petroleum Company

Contractor

Wildcat


990 Ft. from N. Line

Ft. from S. Line

330 Ft. from E. Line

Ft. from W. Line

SE NE NW

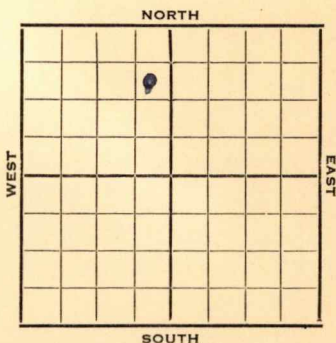

1952

Elev. 1127' REPORT

11/5

Location

12/3

Spud 11-16-52

D&A

TD 3465'

8" @ 142

Howard 1265, Severy sd 1333',
Br. lime 2150, Stal. 2178, KC
2815, Bart 3342, Miss 3413

DST 3412-28, opn 2 hrs., rec.
105' mud & sw 780#

TD 3465


D&A

ABANDONED

County Cowley State Kansas
 Sec. 2 (Blk. 35 (Sur. 3E Map No. (Twp.) (Rge.)

Operator Aladdin Petroleum
 Well No. 1 Farm Marshall

Elev. 1127 Location SE NE NW

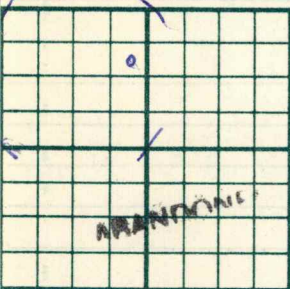

990 Ft. From N Line NW
 330 Ft. From E Line Quarter

1st. Report

Completion DEC 3 1952

Remarks Wildcat

Spudding Date 11-16-52

Orlg. Data D & A TD 3465

8"@ 142 Howard 1265 Severy sd. 1333

Br. lime 2150 Stal. 2178 KC 2815


Bart. 3342 Miss. 3413 DST 3412-28

open 2 hr. Rec. 105' mud & sw 780#

TD 3465

D & A

J. G. McGEHEE

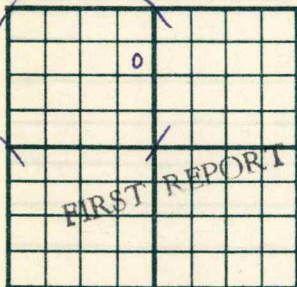County Cowley State KansasSec. 2 (Blk.) 35 (Sur.) 3E Map No.Operator Aladdin PetroleumWell No. 1 Farm MarshallElev. Location SE NE NW990 Ft. From N Line NW330 Ft. From E Line Quarter1st. Report NOV 5 1952

Completion

Remarks

Spudding Date

Drlg. Data WildcatLocation