


Map No. _____ Sec. 34 Twp. 25 R. SWell No. 1 Tracts Farm _____Selley Oil Company _____

NORTH

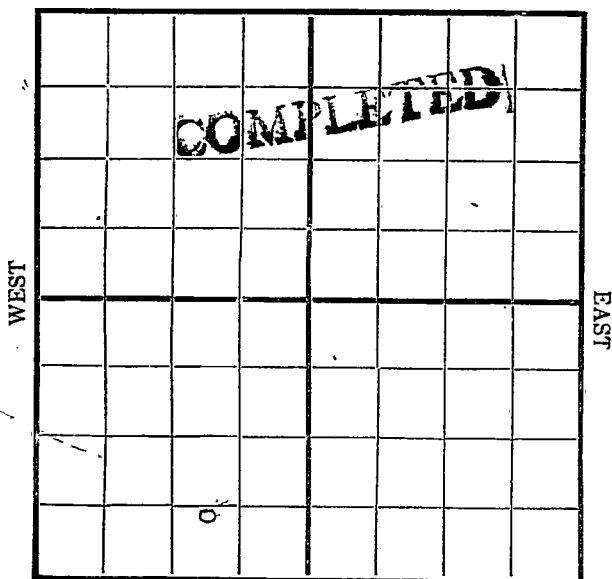

SOUTH

Location _____

Rig Up _____

Drilling Remarks:

Drilling Remarks:

RECORD

PRODUCTION

Cased _____ in _____ Ft.

1st 24 hrs. Nat. _____

Sand _____

1st 24 hrs. after shot _____

Gas _____

Gas _____ Cu. Ft.


Oil _____

Dry Hole _____

Total Depth _____

Abandoned _____

Map No. _____ Sec. 34 Twp. 25 R. 5
 Well No. 192000 Farm _____
Selby Oil Company _____
 NORTH

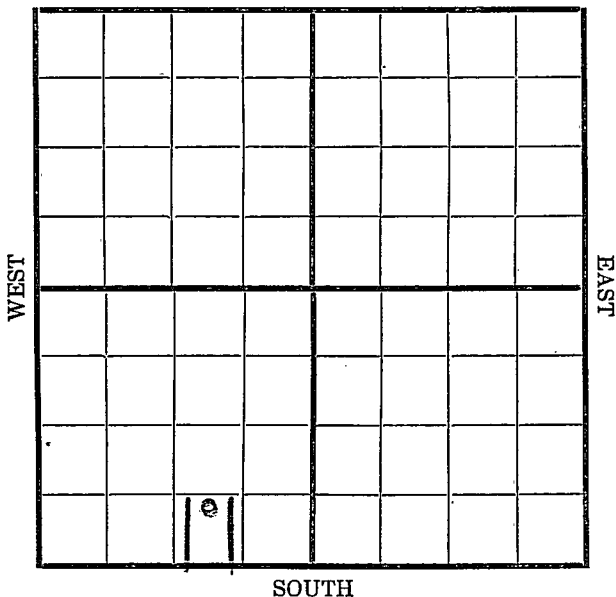

Location _____
 Rig Up ☒ _____
 Drilling and remarks _____

RECORD

Cased _____ in. _____ Ft.
 Sand _____
 Gas _____
 Oil _____
 Total Depth _____

FIRST REPORT


PRODUCTION

1st 24 hrs. Nat. _____
 1st 24 hrs. after shot _____
 Gas _____ Cu. Ft.
 Dry Hole _____
 Abandoned _____

Date

3/21, 1917 Conley Scout

Map No. _____ Sec. 34 Twp. 25 R. 5
 Well No. 1 Tract Farm _____
Selling Oil Company _____
 NORTH

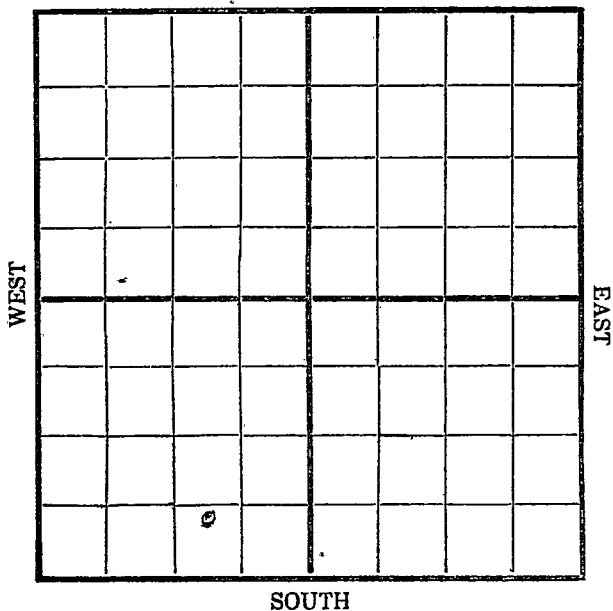

Location _____

Rig Up ☒ _____

Drilling and remarks

Rigging up

RECORD

Cased _____ in. _____ Ft.

Sand _____

Gas _____

Oil _____

Total Depth _____

PRODUCTION

1st 24 hrs. Nat. _____

1st 24 hrs. after shot _____

Gas _____ Cu. Ft.

Dry Hole _____

Abandoned _____

Date


3/26 1917 C. O. D. Scout

Map No. _____ Sec. 34 Twp. 25 R. 5
 Well No. 1922 Farm _____
Delby Company _____

NORTH

WEST

EAST

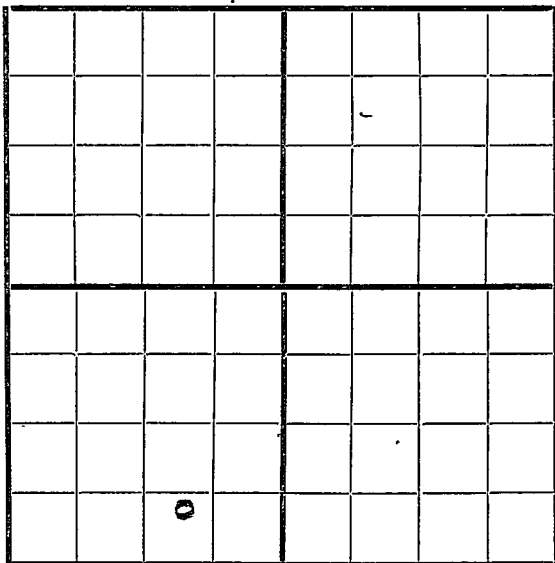

SOUTH

Location _____
 Rig Up _____
 Drilling and remarks _____

*Rising
up*

RECORD

Cased _____ in. _____ Ft.
 Sand _____
 Gas _____
 Oil _____
 Total Depth _____

PRODUCTION

1st 24 hrs. Nat. _____
 1st 24 hrs. after shot _____
 Gas _____ Cu. Ft.
 Dry Hole _____
 Abandoned _____

Date


4/15, 1917 Cand Scout

Map No. _____ Sec. 34 Twp. 25 R. 5
 Well No. 1 Tract Farm _____
22by Company _____

NORTH

WEST

EAST

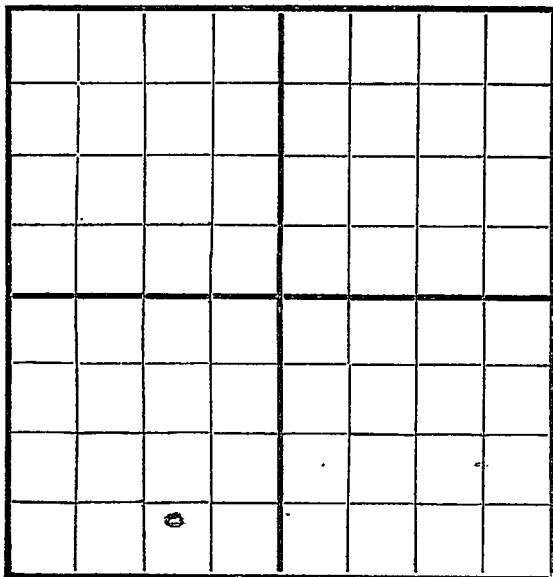

SOUTH

Location _____
 Rig Up _____
 Drilling and remarks _____

Rigged up

RECORD


Cased _____ in. _____ Ft.
 Sand _____
 Gas _____
 Oil _____
 Total Depth _____

PRODUCTION

1st 24 hrs. Nat. _____
 1st 24 hrs. after shot _____
 Gas _____ Cu. Ft.
 Dry Hole _____
 Abandoned _____

Date 4/11, 1917 Carley Scout

Map No. _____ Sec. 34 Twp. 25 R. 5
 Well No. 19 Trust (unit) Farm _____
Selling Company _____
 NORTH

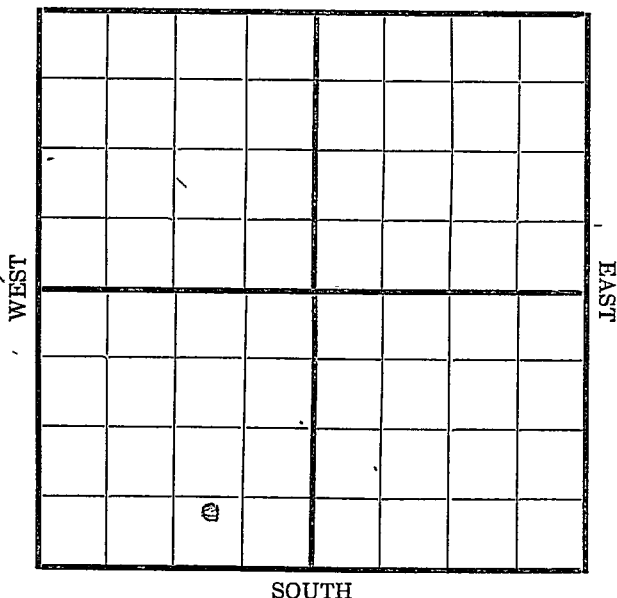

Location _____
 Rig Up _____
 Drilling and remarks

1700'

RECORD

Cased _____ in. _____ Ft.
 Sand _____
 Gas _____
 Oil _____
 Total Depth _____


PRODUCTION

1st 24 hrs. Nat. _____
 1st 24 hrs. after shot _____
 Gas _____ Cu. Ft.
 Dry Hole _____
 Abandoned _____

Date

4/19, 1912 Early Scout

Map No. _____ Sec. 34 Twp. 25 R. 5
 Well No. 19 Farm _____
Selly Company _____
 NORTH

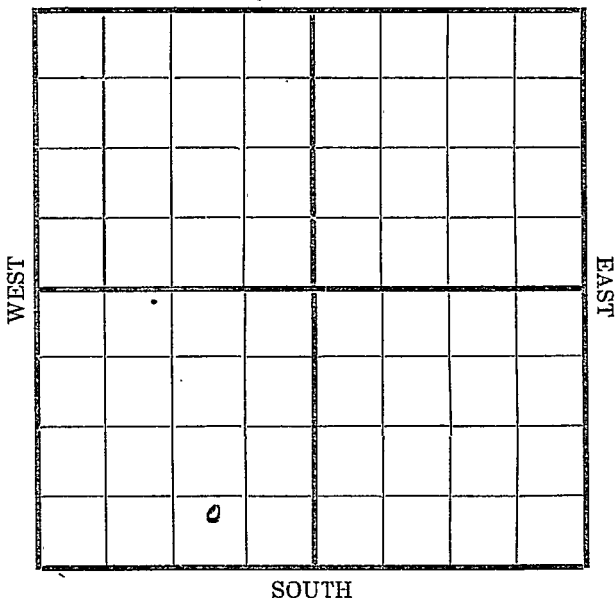

Location _____
 Rig Up _____
 Drilling and remarks

2-2-17

RECORD

Cased _____ in. _____ Ft.
 Sand _____
 Gas _____
 Oil _____
 Total Depth _____

PRODUCTION

1st 24 hrs. Nat. _____
 1st 24 hrs. after shot _____
 Gas _____ Cu. Ft.
 Dry Hole _____
 Abandoned _____

Date

APR 26 1917


191

C. S. Selly

Scout

Map No. _____ Sec. 34 Twp. 25 R. 5Well No. 1 Tracts Farm __________Selly Company _____

NORTH

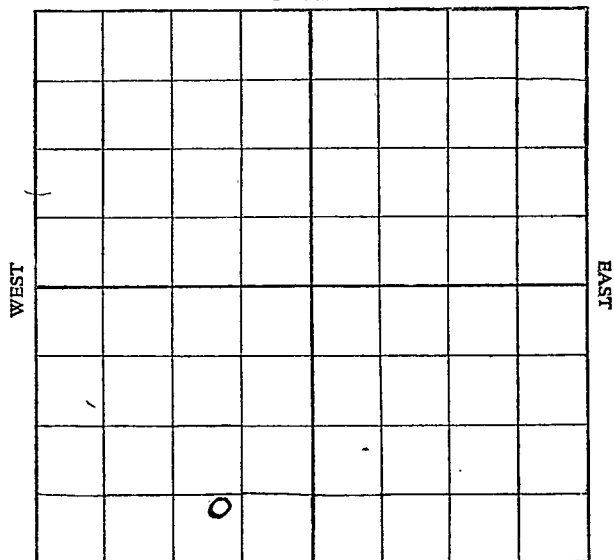

SOUTH

Location _____

Rig up _____

Drilling and remarks:

D-2300

RECORD

Cased _____ in. _____ Ft.

Sand _____

Gas _____

Oil _____

Total Depth _____

PRODUCTION

1st 24 hrs. Nat. _____

1st 24 hrs. after shot _____


Gas _____ Cu. Ft.

Dry Hole _____

Abandoned _____

Date

5/5, 1917, Crocker Scout

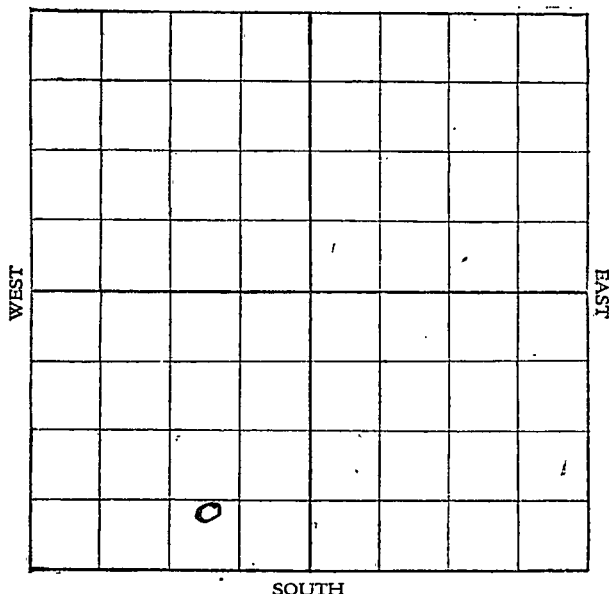Map No. _____ Sec. 34 Twp. 25 R. 5Well No. 1 Tracts (Smith) FarmSelby et al Company
NORTH

Location _____

Rig up _____

Drilling and remarks:

D-2580'Show good

RECORD

Cased _____ in. _____ Ft.

Sand _____

Gas _____

Oil _____

Total Depth _____

PRODUCTION

1st 24 hrs. Nat. _____

1st 24 hrs. after shot _____

Gas _____ Cu. Ft.

Dry Hole _____


Abandoned _____

Date

5/12, 1917, Crocker Scout

Map No. _____ Sec. 34 Twp. 25 R. 5Well No. 1 Tracts Farm _____Selby Company _____

NORTH

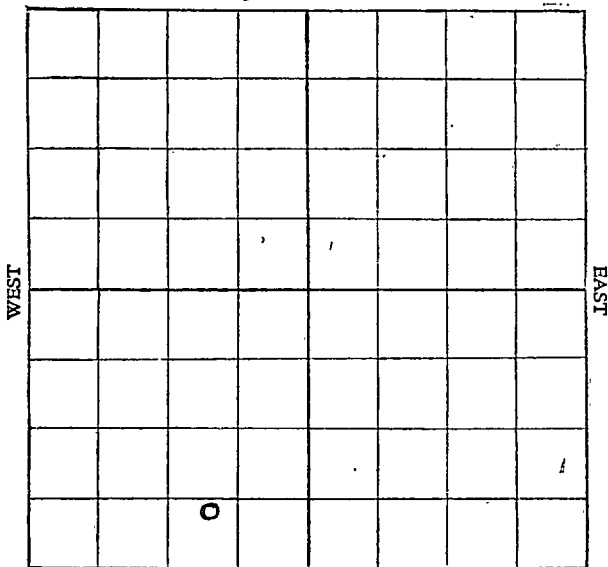

SOUTH

Location _____

Rig up _____

Drilling and remarks:

2470' showing oil.
Dry - 2580'

RECORD

Cased _____ in. _____ Ft.

Sand _____

Gas _____

Oil _____

Total Depth _____

PRODUCTION

1st 24 hrs. Nat. _____

1st 24 hrs. after shot _____

Gas _____ Cu. Ft.

Dry Hole _____


Abandoned _____

Date

5/19, 19*17*, *Crocker* Scout

Map No. _____ Sec. 34 Twp. 25 R. 5Well No. 1 Tracts Farm __________Selby Company _____

NORTH

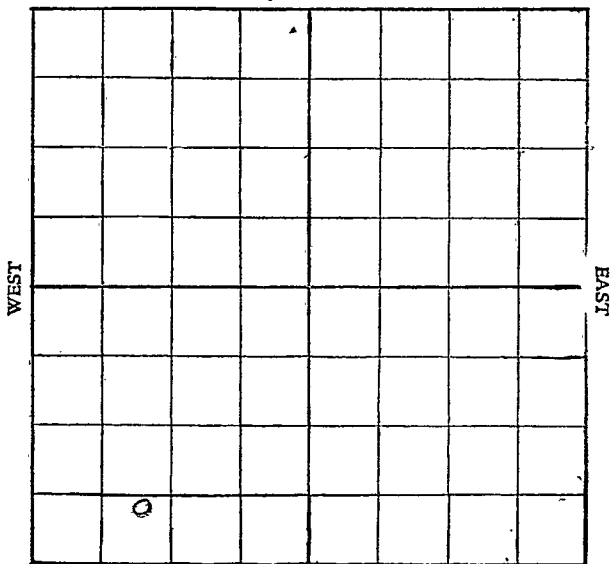

SOUTH

Location _____

Rig up _____

Drilling and remarks:

S.D. 2800'

RECORD

Cased _____ in. _____ Ft.

Sand _____

Gas _____

Oil _____

Total Depth _____

PRODUCTION

1st 24 hrs. Nat. _____

1st 24 hrs. after shot _____

Gas _____ Cu. Ft.

Dry Hole _____

Abandoned _____

Date


5726.7 Brocker Scout

Map No. Sec. 34 Twp. 25 R. 5Well No. 1 Trueto FarmSadby Company

NORTH

WEST

EAST

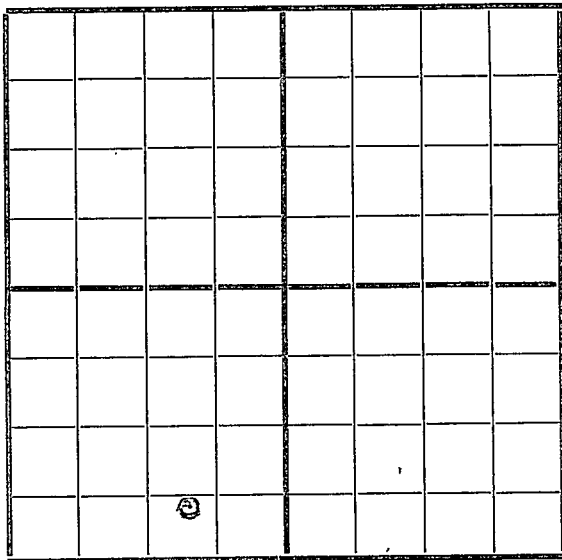

SOUTH

Location

Rig up.....

Drilling and Remarks:

2985 Hole
Full of Water

RECORD

Cased in. Ft.

Sand.....

Gas

Oil.....

Total Depth

PRODUCTION

1st 24 hrs. Nat.

1st 24 hrs. after shot.....

Gas..... Cu. Ft.

Dry Hole.....

Abandoned.....


Date

6/27, 1917

B. J. Crocker
 Scout

Map No. _____ Sec. 34 Twp. 25 R. 5Well No. 1 Tracts. (mils) Farm _____Selby. Company _____

NORTH

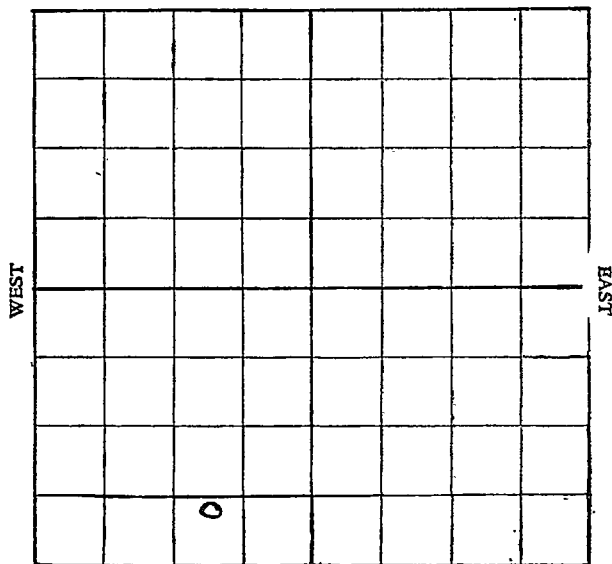

SOUTH

Location _____

Rig up _____

Drilling and remarks:

*Plugging
back to 2475
put in perforated
joint. Total
depth 2985'*

RECORD

Cased _____ in. _____ Ft.

Sand _____

Gas _____

Oil _____

Total Depth _____

PRODUCTION

1st 24 hrs. Nat. _____

1st 24 hrs. after shot _____

Gas _____ Cu. Ft.

Dry Hole _____

Abandoned _____

Date

JUN 9 - 1917

191


B. J. Crocker Scout

Map No. _____ Sec. 34 Twp. 25 R. 5Well No. 2 Tracts (units) Farm __________
Sally Company _____

NORTH

WEST

EAST

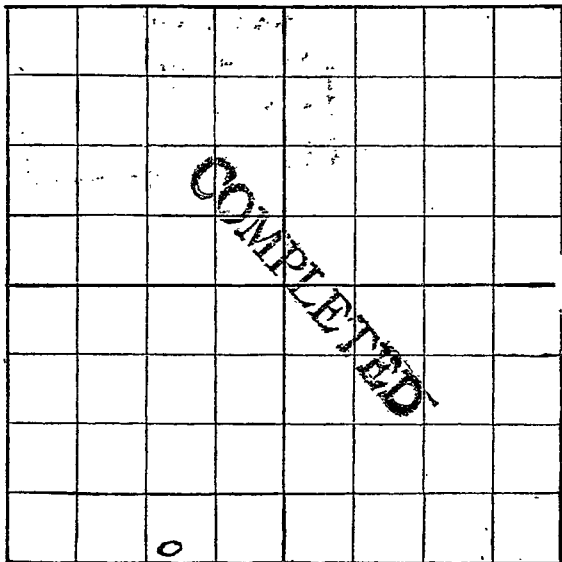

SOUTH

Location _____

Rig up _____

Drilling and remarks:

RECORD

Cased _____ in. _____ Ft.

Sand _____

Gas _____

Oil 2571-2638Total Depth 2638

PRODUCTION

1st 24 hrs. Nat. _____

1st 24 hrs. after shot _____

Gas _____ Cu. Ft.

Dry Hole _____

Abandoned _____

Date


JUN 9 - 1917

191

E. J. Crocker Scout

Map No. _____ Sec. 34 Twp. 25 R. 5Well No. 1 Tracts Farm __________Selby_____
Company

NORTH

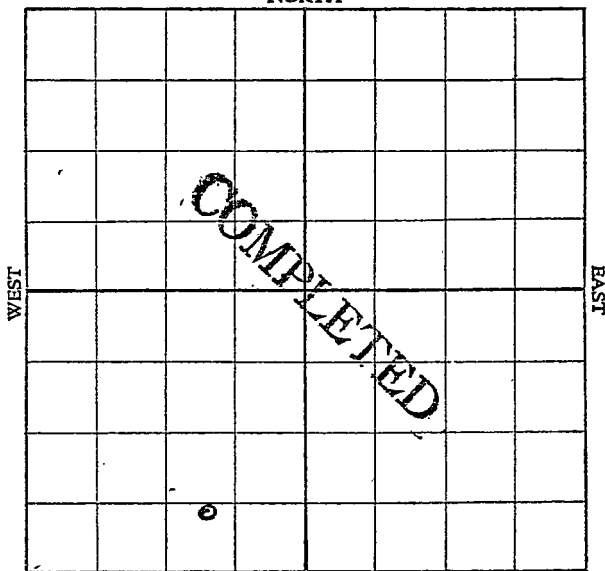

SOUTH

Location _____

Rig up _____

Drilling and remarks:

*Plugged back
to 2568'*

*Good for 30
bbls.*

RECORD

Cased _____ in. _____ Ft.

Sand _____

Gas _____

Oil 2470-2580Total Depth 2995

PRODUCTION

1st 24 hrs. Nat. _____

1st 24 hrs. after shot _____

Gas _____ Cu. Ft.

Dry Hole _____

Abandoned _____

Date JUN 16 1917

_____, 191_____, E. J. L. L. Scout