


Section 5- Township 35 Range 3E

Well No. 2 L. V. Scott

Company Texas Co.

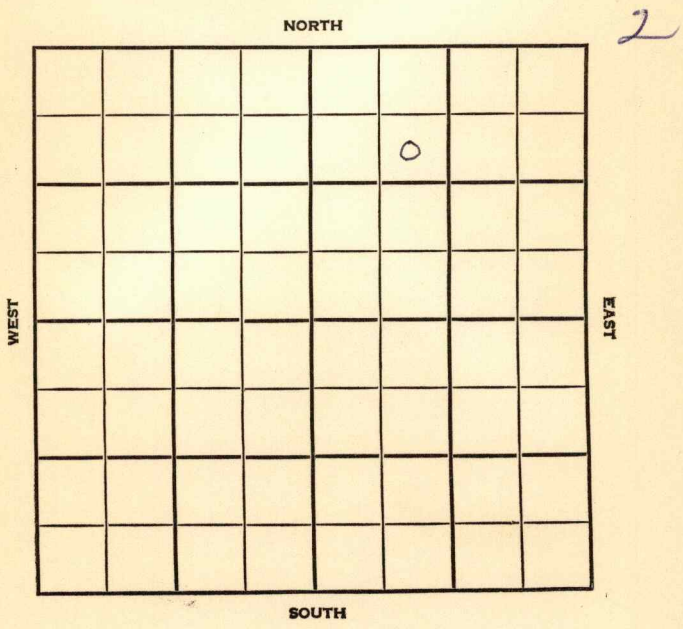

Cowley

KANSAS

SEC.	TWP.	R.
5	35	3 E

WELL NO. # 2 L. V. Scott FARM

COMPANY Texas Company

CONTRACTOR Capitt

Gibson Pool


990 Ft. from N. Line

Ft. from S. Line

Ft. from E. Line

990 Ft. from W. Line

SE NW NE

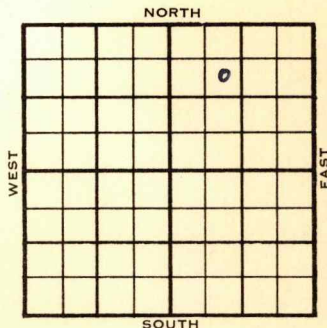

1955	ELEVATION	REPORT
------	-----------	--------

3/30 Location

(Blk.)
(Twp.)

Texas Company

2

Location

FIRST REPORT

M


MAR 30 1955

Remarks

Capitt - Contr.

Gibson Pool

Gibson Pool

Location

FABEN GILSTRAP