


Section 6 Township 35 Range 3EWell No. 2 AlbrightCompany McNeish & Gralapp

NORTH

2

WEST

EAST

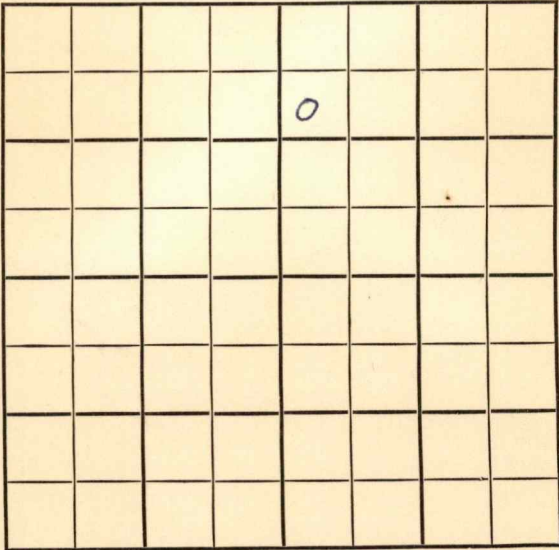

SOUTH

Cowley

KANSAS

SEC.	TWP.	R.
6	35	3E

WELL NO.

#2 Albright

FARM

COMPANY

McNeish & Gralapp

CONTRACTOR

Watson

Gibson Ext.


_____ Ft. from N. Line

_____ Ft. from S. Line

_____ Ft. from E. Line

_____ Ft. from W. Line

SW NW NE

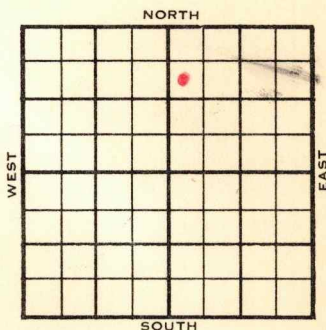

1955

ELEVATION

1189'

REPORT

7/20 MIR

8-17 8 5/8" @ 120/100 D & A

L. ayton 2760 1571 B.K.C. Cleve. 2950
1761 Ce. Oswego 3095 1906 C. Bart
3493 2304 M. 3505 2316 T.D. 3511

ABANDONED

County	Cowley			Elev.	
Sec.	6	Twp.	35	Rgs.	3E
Company	McNeish & Gralapp				
Farm Name	Albright			No.	2

TOPS	DEPTH	LOG	DATUM	Loc. in Sec.
Anh.				SW NW NE
T.P.				
H.				
Tr.				
Dg.				
B.L.				
L.				Geol.
K.C.				
B.K.C.				Contr.
Ce.				Watson
C.				
M.				
M.				Pool
K.				Gibson Ext.
Mz.				
Me.				
V.				
S.				
S.				
A.				
R.				
Pf.				
G.				
F.D.				

Use.

JUL 20 '58

FIRST REPORT

Date Comm.

M I R

County Cowley Elev. 1189
Sec. 6 Twp. 35 Rge. 3E
Company McNeish & Gralapp
Farm Name Albright No. 2

TOPS	DEPTH	LOG	DATUM
Anh.			
TP.			
H.			
Tr.			
Dg.			
BL.			
L. <u>ayton</u>		<u>2760</u>	<u>1571</u>
K.C.			
B.K.C. <u>Chene</u>		<u>2950</u>	<u>1761</u>
Ce. <u>Samuels</u>		<u>3095</u>	<u>1906</u>
C. <u>Bart</u>		<u>3493</u>	<u>2304</u>
M.		<u>3505</u>	<u>2316</u>
M.			
K.			
Mz.			
Me.			
V.			
S.			
S.			
A.			
R.			
Pe.			
G.			
T.D.	<u>3511</u>		

Loc. in Sec. SW NW NE
Geol. _____
Contr. Watson
Pool _____
Gibson Ext. _____

ABANDONED

Date Comm. 8-4-55 AUG 17 1955
8 5/8" @ 120/100
D & A