

Cowley

KANSAS

SECTION 6 TOWNSHIP 35 RANGE 3E

WELL NO. #3 Albright

COMPANY Hill & Hill

NORTH

4

0							
U							

WEST

EAST

SOUTH

SEC. 6	TWP. 35	R. 3E
-----------	------------	----------

WELL NO. #3 Allbright FARM

COMPANY Hill & Hill

CONTRACTOR Kriswell

Murphy


\_\_\_\_\_ FT. FROM N. LINE

\_\_\_\_\_ FT. FROM S. LINE

\_\_\_\_\_ FT. FROM E. LINE

\_\_\_\_\_ FT. FROM W. LINE

C  $W\frac{1}{2}$  NW NW

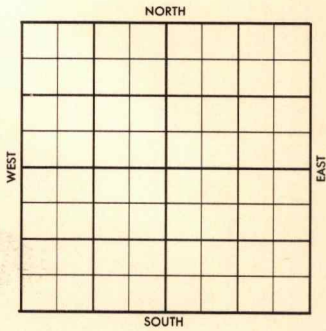

1956	ELEVATION	REPORT
------	-----------	--------

5-23 Comm. 5-16-56  
10" @ 140 w/160  
Drlg. 2337

6-6  $5\frac{1}{2}$ " @ 3553  
P/ 30 BO / 15 BWPD  
Bartl. 3491  
TD 3554'

COMPLETED

Co.

County Cowley Elev. \_\_\_\_\_  
 Sec. 6 Twp. 35 Rge. 3E  
 Company Mill & Hill  
 Farm Name Allbright No. 3

TOPS	DEPTH	LOG	DATUM	Loc. in Sec.
Anh.				C W $\frac{1}{2}$ NW NW
TP.				
H. <u>Bartl.</u>	<u>3491</u>			
Tr.				
Dg.				
BL.				
L.				Geol. _____
K.C.				Contr. _____
B.K.C.				
Ce.				<u>Kriswell</u>
C.				
M.				Pool
M.				<u>Murphy</u>
K.				
Mz.				
Me.				
V.				
S.				
S.				
A.				
R.				
PE.				
G.				
TD.	<u>3554</u>			

Loc.



No.

Date Comm. 5-16-56 JUN 6 1956

Sec.

10" @ 140/160 drlg. 2337 MAY 29 '56

5 1/2 @ 3553 JUN 6 '56 V. 328 380-98

T.

500 MCA, Fl 30 BO + P5 BWPP

BY,

R.

County Cowley Elev. \_\_\_\_\_  
 Sec. 6 Twp. 35 Rge. 3E  
 Company Hill & Hill  
 Farm Name Allbright No. 3

TOPS	DEPTH	LOG	DATUM
Anh.			
Tr.			
H.			
Tr.			
Dg.			
BL.			
L.			
K.C.			
B.K.C.			
Ce.			
C.			
M.			
M.			
K.			
Mz.			
Me.			
V.			
S.			
S.			
A.			
R.			
PE.			
G.			
T.D.			

Loc. in Sec. C 1/2 NW NW

Geol. \_\_\_\_\_

Contr. Kriswell

Pool Murphy

0

FIRST REPORT

MAY 23 '56

Date Comm. 5-16-56  
10" @ 140/160 drlg. 2337

APR 5 9 1956

24

R.G.

Co.  
Lse.  
No.  
Sec.  
T.  
R.