


Cowley

KANSAS

SECTION 5 TOWNSHIP 35 RANGE 3 E

WELL NO. #1 Vickery

COMPANY Rupp-Ferguson

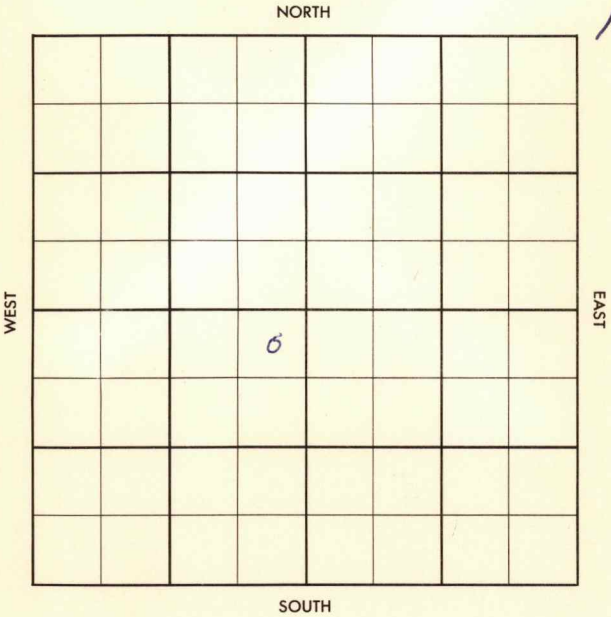

Cowley

KANSAS

SEC.	TWP.	R.
5	35	3E

WELL NO.

#1 Vickery

FARM

COMPANY

Rupp-Ferguson

CONTRACTOR

Co. tools

Murphy


Ft. from N. Line

Ft. from S. Line

Ft. from E. Line

Ft. from W. Line

NE NE SW

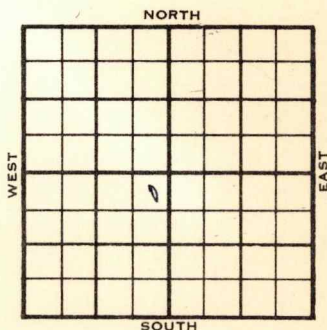

	ELEVATION	REPORT
1955		
12-28	Comm. 12-23-55 8" @ 136/120 Drlg. 975	
1956		
1-11	DST 3220-32 op 1 hr. rec. 2½' mud, Off D & A Stal. 2272 Layton 2704 KC. 2890 BKC. 3010 Prue 3220 Chatta 3733 Miss 3442 S. 3766 S. Sd. 3796 A. 3836 TD 3860'	

ABANDONED

County Cowley Elev. _____
 Sec. 5 Twp. 35 Rge. 3E
 Company Rupp-Ferguson
 Farm Name Vickery No. 1

TOPS	DEPTH	LOG	DATUM	Loc. in Sec.
Anh.				NE NE SW
Tp.				
H.				
Tr.				
Dg.				
Bl.				
L.				Geol.
K.C.				Contr.
B.K.C.				Co. tools
Ce.				Pool
C.				Murphy
M.				
M.				
K.				
Mz.				
Ma.				
V.				
S.				
S.				
A				
R.				
Pe.				
G.				
T.D.				

FIRST REPORT
 DEC 28 '55

Date Comm. 12-23-55
8" @ 136/120 drlg. 975

TOPS	DEPTH	LOG	DATUM	Loc. in Sec.
Anh.				NE NE SW
TP.				
H. <i>stal</i>	<i>2272</i>			
Tr. <i>Layton</i>	<i>2704</i>			
Dg.				
BL.				
L.				
K.C.	<i>2890</i>			Geol. _____
B.K.C.	<i>3010</i>			
Ce. <i>Prue</i>	<i>3220</i>			Contr. _____
C. <i>Chatter</i>	<i>3733</i>			Co. tools
M. <i>ies</i>	<i>3442</i>			
M.				Pool
K.				Murphy
Mz.				
Me.				
V.				
S.	<i>3766</i>			
S. <i>sd</i>	<i>3796</i>			
A	<i>3836</i>			
R.				
Pe.				
G.				
TD.	<i>3860</i>			

Date Comm.	12-23-55	JAN 11 1956
8" @ 136/120	DST 3220-32	open 1 hr.
rec. 2½' mud	O#	

D & A